


PLS Group, LLC  
 109 Coronado Ct. - Bldg 7  
 Fort Collins, Colorado 80525

# WELL LOCATION CERTIFICATE

THIS MAP DOES NOT  
 REPRESENT A BOUNDARY SURVEY

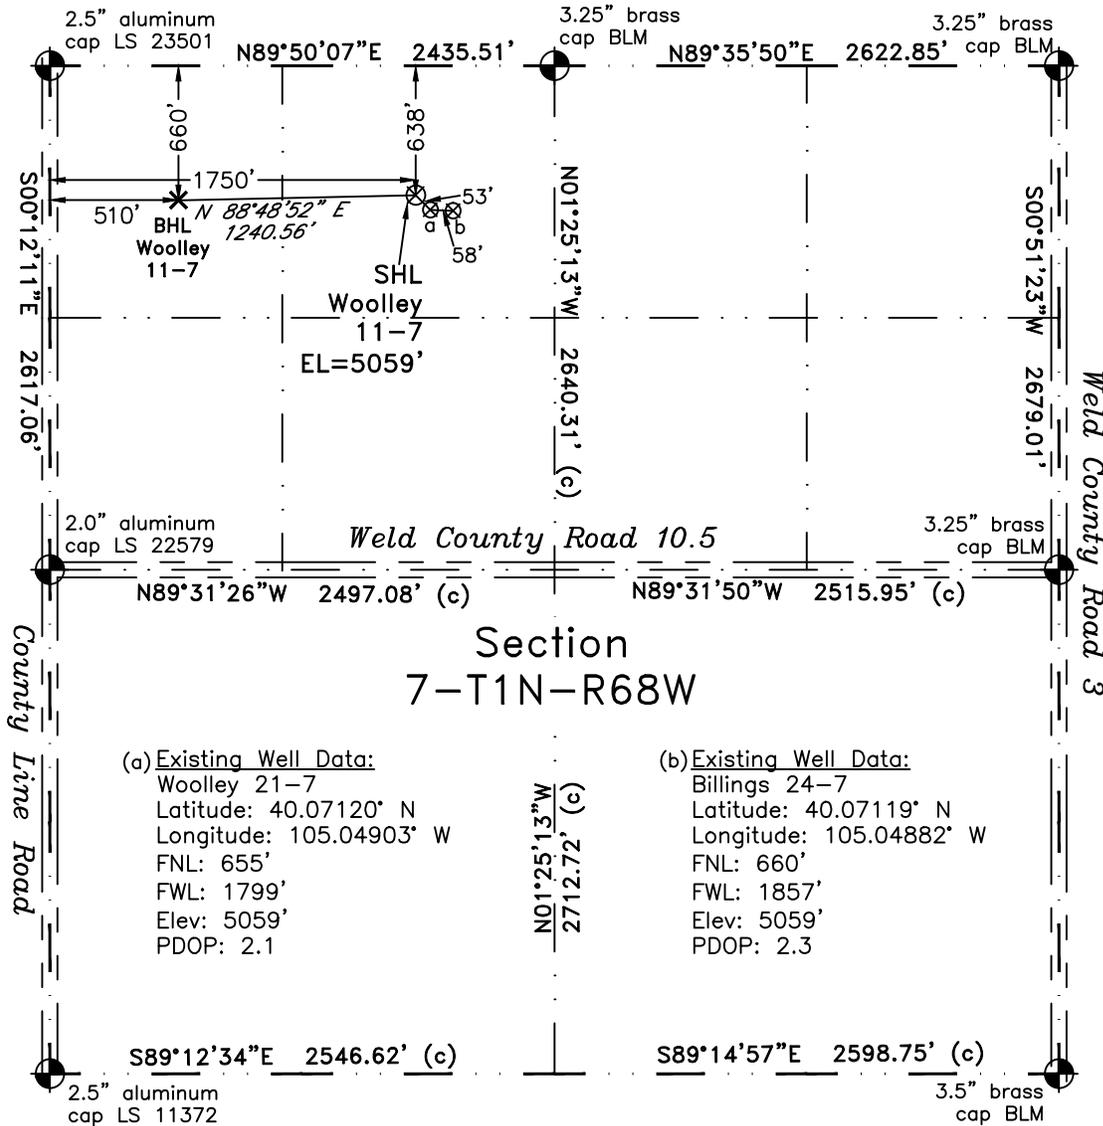

(a) Existing Well Data:  
 Woolley 21-7  
 Latitude: 40.07120° N  
 Longitude: 105.04903° W  
 FNL: 655'  
 FWL: 1799'  
 Elev: 5059'  
 PDOP: 2.1

(b) Existing Well Data:  
 Billings 24-7  
 Latitude: 40.07119° N  
 Longitude: 105.04882° W  
 FNL: 660'  
 FWL: 1857'  
 Elev: 5059'  
 PDOP: 2.3

LEGEND  
 — found survey monument  
 (c) — calculated dimension

In accordance with a request from Doug Pearlman of EnCana Oil & Gas (USA) Inc., PLS Group, LLC has determined the location of the **Woolley 11-7** well site to be SHL: 638' FNL and 1750' FWL, (BHL 660' FNL and 510' FWL) as measured at ninety (90) degrees from the section lines of Section 7, Township 1 North, Range 68 West, 6th Principal Meridian, County of Weld, CO.

Proposed Surface Hole Data:  
 Latitude: N 40.07125° BHL(40.07120°)  
 Longitude: W 105.04920° BHL(105.05364°)

Nearest: Building 1356' northwest Above Ground Utility 1785' west  
 Public Road 1735' west Railroad 4,490' southeast  
 Property Line 338' northwest  
 PDOP: 2.5

- Notes:
- 1) Bearings and distances based upon NAD 83 Colorado North State Plane Coordinates using RTK GPS observations taken on 11/03/2010 by operator Craig Burke.
  - 2) Conversion factor to ground (1.000277368).
  - 3) Elevations based on NAVD 88 GPS heights and Geoid 2003 corrections.
  - 4) See improvement map for visible improvements within 400 feet of pad site.
  - 5) The location falls on agricultural land.

**NOTICE:** According to Colorado law you MUST commence any legal action based upon any defect in this W.L.C. within three years after you first discover such defect. In no event may any action based upon any defect in this W.L.C. be commenced more than ten years from this said date of the certification shown hereon.

I hereby certify that this Well Location Certificate was prepared by me or my duly licensed superior or assistant surveyor for and on behalf of EnCana Oil & Gas (USA) Inc., that it is a correct and true statement of the location of the well site and that it is not to be relied upon for establishment of any easements, buildings, or other future improvements. The

John Robert McGehee LS#38219  
 Well: Woolley 11-7