



FOR OGCC USE ONLY
RECEIVED
JAN 20 2011
COGCC

1120 Lincoln Street, Suite 801, Denver Colorado 80203 (303) 894-2100 Fax (303) 894-2109

WELL ABANDONMENT REPORT

Submit original plus one copy. This form is to be submitted as an intent whenever a plugging is planned on a borehole. The approved intent shall be valid for six months after the approval date; after that period a new intent will be required. After the plugging is complete, this form and one copy shall again be submitted as a subsequent report of the work as actually completed.

OGCC Operator Number: <u>100185</u>	Contact Name & Telephone: <u>RUTHANN MORSS</u>	24 hour notice required, contact: DAVE ANDREWS Tel: <u>970-456-5262</u>															
Name of Operator: <u>ENCANA OIL & GAS (USA) INC.</u>	No: <u>720-876-5060</u>																
Address: <u>370 17TH STREET, SUITE 1700</u>	Fax: <u>720-876-6060</u>	Complete the Attachment Checklist <table border="1"> <tr> <td>Wellbore Diagram</td> <td>Oper</td> <td>OGCC</td> </tr> <tr> <td>Cement Job Summary</td> <td>X</td> <td></td> </tr> <tr> <td>Wireline Job Summary</td> <td></td> <td></td> </tr> <tr> <td></td> <td></td> <td></td> </tr> <tr> <td></td> <td></td> <td></td> </tr> </table>	Wellbore Diagram	Oper	OGCC	Cement Job Summary	X		Wireline Job Summary								
Wellbore Diagram	Oper		OGCC														
Cement Job Summary	X																
Wireline Job Summary																	
City: <u>DENVER</u> State: <u>CO</u> Zip: <u>80202</u>	Other wells on the lease? <input checked="" type="checkbox"/> Y <input type="checkbox"/> N																
API Number: <u>05077.85670000</u> OGCC Lease No.: _____	Well Name: <u>SHEAR</u> Number: <u>30-4</u>																
Location (QtrQtr, Sec, Twp, Rng, Meridian): <u>NWNW SEC 30 T9S-R95W 6TH P.M.</u>	County: <u>MESA</u> Federal, Indian or State Lease Number: <u>36016</u>																
Field Name: <u>PLATEAU</u> Field Number: <u>69300</u>																	

Notice of Intent to Abandon Subsequent Report of Abandonment

Only Complete the Following Background Information for Intent to Abandon

Latitude: 39.25104 Longitude: -108.04143

GPS Data: Date of Measurement: 7-25-06 PDOP Reading: 2.8 Instrument Operator's Name: BUCK HINSON

Reason for Abandonment: Dry Production Sub-economic Mechanical Problems Other

Casing to be Pulled: Yes No Top of Casing Cement: UNKNOWN

Fish in Hole: Yes No If yes, explain details below:

Wellbore has Uncemented Casing Leaks: Yes No If yes, explain details below:

Details: _____

Current and Previously Abandoned Zones

Formation	Perforations - Top	Perforations - Bottom	Date Abandoned	Method of Isolation (None, Squeezed, BP, Cement, etc.)	Plug Depth
CZ-CR	4950	5180	1-2-08	CIBP + 2SX CMT ON TOP	4900'

Casing History

String	Size of Hole	Size of Casing	Weight per ft	Setting Depth	Sacks Cement	Cement Bottom	Cement Top
SURFACE	12.25	8.625	24	523	350	523	surface
PRODUCTION	7.875	4.5	11.6	5318	500	5318	UNKNOWN

Plugging Procedure for Intent and Subsequent Report

CIBP #1: Depth 725 with 2 sacks cmt on top. CIBP #2: Depth 4900 with 2 sacks cmt on top. NOTE: Two (2) sacks cement required on all CIBPs.

Set _____ sks cmt from _____ ft. to _____ ft. in Casing Open Hole Annulus

Set _____ sks cmt from _____ ft. to _____ ft. in Casing Open Hole Annulus

Set _____ sks cmt from _____ ft. to _____ ft. in Casing Open Hole Annulus

Set _____ sks cmt from _____ ft. to _____ ft. in Casing Open Hole Annulus

Set _____ sks cmt from _____ ft. to _____ ft. in Casing Open Hole Annulus

Perforate and squeeze at 1200 ft. with 40 sacks Leave at least 100 ft. in casing Cmt retainer @1100'

Perforate and squeeze existing holes: 592-691 ft. with 234 sacks Leave at least 100 ft. in casing Circ cement to surface

Perforate and squeeze at _____ ft. with _____ sacks Leave at least 100 ft. in casing

Set 20 sacks half in, half out surface casing from 0 ft. to 50 ft.

Set 20 sacks at surface (50' to SURFACE)

Cut four feet below ground level, weld on plate Dry-Hole Marker: Yes No

Set _____ sacks in rat hole Set _____ sacks in mouse hole

Additional Plugging Information for Subsequent Report Only

Casing Recovered: _____ ft. of _____ in. casing Plugging date: 11-19-09

*Wireline Contractor: _____

*Cementing Contractor: BJ Services

Type of Cement and Additives Used: Class G + 0.04 lbs SF

***Attach job summaries.**

I hereby certify that the statements made in this form are, to the best of my knowledge, true, correct, and complete.

Print Name: Ruthann Morss RUTHANN MORSS

Signed: _____ Title: REGULATORY ANALYST Date: 01/18/11

OGCC Approved: David Andrews Title: PE II Date: 1/27/2011

CONDITIONS OF APPROVAL, IF ANY:


Downhole Schematic for Shear 30-4

Project: South Piceance
 Area: Plateau
 As of: 11/19/2009

API #: 05077085670000
 County MESA
 GL: 6202'

Surface Location:
 BHL
 KB to GL 10'

NWNW Sec 30 T9S-R95W 6th PM
 NWNW Sec 30 T9S-R95W 6th PM
 KB: 6212'

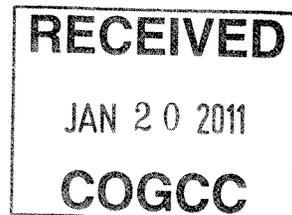

Casing Details Section	Hole	Casing	Mass	Set At	Length	Thread	Grade	Description
Conductor								
Surface	12.250	8.625	24.000	523.00				No Details
Production	7.875	4.500	11.600	5,318.00	5,318.00			No Details

Cement Details Section	Sequence	Top	Sacks	Notes/Admixes
Surface	Lead	0	350	unknown
Production	Lead	unknown	500	unknown

Tubing and Downhole Equipment O.D.	Length	Depth	Description
	10		KB 2' correction
6.203	0.41	8.41	Hanger
2.375	4759	4767.4	146 lbs 2 3/8" 4.7# EUE tbq
2.375	1.01	4768.4	X nipple
2.375	32.56	4801	1 ft tbq as above
3.063	0.4	4801.4	Notched collar
		1100.0	cement retainer

Perforations Stage 1 Date	From	To	Shots
10/3/81	5180	5180	1
	5117	5117	1
	5109	5109	1
	5069	5069	1
	4950	4950	1

Squeeze #1 - P&A Date	From	To	Shots	Sacks Cement
11/19/09	1200	1201	4	40

Frac Summary
 Stage 1: 4,950 - 5,180, 5 - 0.350" shots, 1690 bbls 70 quality foam, 160,000# 20-40 sand. Report date: 10-3-84

Bridge Plug Details Depth	Date Set	Plug Type	Sacks Cement
4900'	1/2/08	CIBP	2
725'	11/18/09	CIBP	2

Cement Squeeze Date	Squeeze	Details
11/18/09	#1	Perf casing @ 1200'. Set cement retainer @ 1100'. Sting into retainer and squeeze off perms with 40 sx Class G neat. Set 4 1.2" CIBP @ 725'.
11/19/09	#2	Pump 234 sx Class G neat down casing and up annulus through existing holes from 592' - 691'. Top off casing and annulus with 20 sx Class G.

Set @ 5318'

PBTD @ 4900'
 TD @ 5328'


CEMENT JOB REPORT



CUSTOMER EnCana Oil & Gas USA Inc		DATE 19-NOV-09	F.R. # 1001526339	SERV. SUPV. DELBERT S GALLEGOS							
LEASE & WELL NAME SHEAR #30-4 - API 05077085670000		LOCATION 30-9S-95W		COUNTY-PARISH-BLOCK Mesa Colorado							
DISTRICT Grand Junction		DRILLING CONTRACTOR RIG #		TYPE OF JOB Squeeze Perforation							
SIZE & TYPE OF PLUGS		LIST-CSG-HARDWARE		PHYSICAL SLURRY PROPERTIES							
NONE				SACKS OF CEMENT	SLURRY WGT PPG	SLURRY YLD FT ³	WATER GPS	PUMP TIME HR:MIN	Bbl SLURRY	Bbl MIX WATER	
MATERIALS FURNISHED BY BJ											
Class G Cement+ .04 lbs SF				308	15.8	1.15	4.99		63	36.63	
Available Mix Water 160 Bbl.		Available Displ. Fluid 400 Bbl.		TOTAL					63	36.63	
HOLE			TBG-CSG-D.P.				COLLAR DEPTHS				
SIZE	% EXCESS	DEPTH	SIZE	WGT.	TYPE	DEPTH	GRADE	SHOE	FLOAT	STAGE	
			4.5	10.5	CSG	600					
LAST CASING		PKR-CMT RET-BR PL-LINER			PERF. DEPTH		TOP CONN		WELL FLUID		
SIZE	WGT	TYPE	DEPTH	BRAND & TYPE	DEPTH	TOP	BTM	SIZE	THREAD	TYPE	WGT.
						3250	3250	2.375	1502		
DISPL. VOLUME		DISPL. FLUID		CAL. PSI	CAL. MAX PSI	OP. MAX	MAX TBG PSI		MAX CSG PSI		MIX WATER
VOLUME	UOM	TYPE	WGT.	BUMP PLUG	TO REV.	SQ. PSI	RATED	Operator	RATED	Operator	
4.6	BBLs			0	1200	0	7700	6160	5250	4280	water truck

EXPLANATION: TROUBLE SETTING TOOL, RUNNING CSG, ETC. PRIOR TO CEMENTING:

PRESSURE/RATE DETAIL						EXPLANATION	
TIME HR:MIN.	PRESSURE - PSI		RATE BPM	Bbl. FLUID PUMPED	FLUID TYPE	SAFETY MEETING: BJ CREW <input checked="" type="checkbox"/> CO. REP. <input checked="" type="checkbox"/>	
	PIPE	ANNULUS				TEST LINES	3500 PSI
						CIRCULATING WELL - RIG <input checked="" type="checkbox"/>	BJ <input type="checkbox"/>
04:30						leave yard for location	
06:00						arrive to location	
06:10						tailgate meeting	
06:25						rig up iron and hoses	
07:30						wait on rig to perf and circulate	
09:45						prejob safety meeting	
10:05						rig up to tubing	
10:20	3500	0	5	5	WATER	pressure test lines	
10:25						start injection rate test	
10:32	1000	0	1.4	10	WATER	final rate pressure 1000psi 1.4bpm	
10:40						start batching cement	
10:45	987	0	1.4	2	CEMENT	start pumping cement downhole	
10:52	1000	0	5	7.8	CEMENT	pressure up cut cement short and displace	
10:53	967	0	5	1	WATER	start displacement	
11:01						rig to reverse out 15bbls	
11:10						done for today	
12:30						leave location	
						company rep wants us ready to pump by 0730	
05:30						arrive to location	
05:40						fire heaters and deck engines warm em up	
07:00						prime pump get ready to cement	
08:03						pre job safety meeting	
08:15	10	0	2.4	2	WATER	pump water to establish circulation	
08:16						batch up cement 15.8ppg	
08:19	50	0	2.4	2	CEMENT	start pumping cement	
08:24	50	0	2.4	10	CEMENT	rate and pressure	
08:27	280	0	2.4	20	CEMENT	rate pressure	

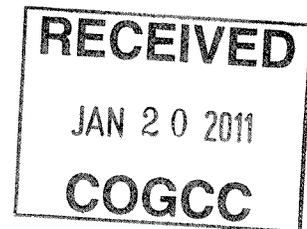

CEMENT JOB REPORT



PRESSURE/RATE DETAIL						EXPLANATION	
TIME HR:MIN.	PRESSURE - PSI		RATE BPM	Bbl. FLUID PUMPED	FLUID TYPE	SAFETY MEETING: BJ CREW <input checked="" type="checkbox"/> CO. REP. <input checked="" type="checkbox"/>	
	PIPE	ANNULUS				TEST LINES	3500 PSI
						CIRCULATING WELL - RIG	<input checked="" type="checkbox"/> BJ <input type="checkbox"/>
08:31	210	0	2.4	30	CEMENT	rate pressure	
08:36	330	0	2.4	40	CEMENT	rate pressure	
08:39	447	0	0	48	CEMENT	cement to surface stop pumping	
08:40						switch to pit wash lines	
						wait on cement to see if it falls back 2 hours	
10:45						we need to mx up a tub a top out the casing	
11:00	50	0	25	1	CEMENT	pumped .5bbls in casing and .5bbls in annulus	
						was up pickle and rig down lines adn hoses	
							SERVICE SUPERVISOR SIGNATURE:
							<i>[Signature]</i>
BUMPED PLUG	PSI TO BUMP PLUG	TEST FLOAT EQUIP.	BBL.CMT RETURNS/ REVERSED	TOTAL BBL. PUMPED	PSI LEFT ON CSG	SPOT TOP OUT CEMENT	
<input type="checkbox"/> Y <input checked="" type="checkbox"/> N		<input type="checkbox"/> Y <input checked="" type="checkbox"/> N		66	0	<input type="checkbox"/> Y <input checked="" type="checkbox"/> N	

RECEIVED
 JAN 20 2011
COGCC