


KINDER MORGAN CO2 COMPANY, LP
HE-5 surface location
736' FSL & 1573' FWL record
6490' grd.el. record
Section 36, T.38 N., R.19 W., NMPM
HE-5 bottom hole
1769' FNL & 1576' FWL
Section 36, T.38 N., R.19 W., NMPM
Montezuma County, CO

Notes:

Distances/dimensions are perpendicular to section/aliquot lines.

GPS was corrected with Aztec, NM CORS, operator was R.J. Caffey CO LS 36562

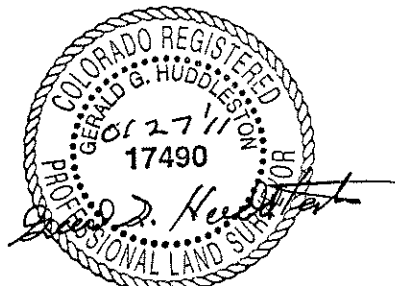

KNOW ALL MEN BY THESE PRESENTS that I, GERALD G. HUDDLESTON, do hereby certify that this plat was prepared from the record well location plat, GLO survey plat and down hole information and does not represent an actual survey by me.

date of plat : 01/27/2011