




Lat40°, LLC 1635 Foxtrail Drive, Suite 325 Loveland, CO 80538

WELL LOCATION CERTIFICATE

THIS MAP DOES NOT REPRESENT A BOUNDARY SURVEY

SECTION: 30
TOWNSHIP: 7N
RANGE: 63W

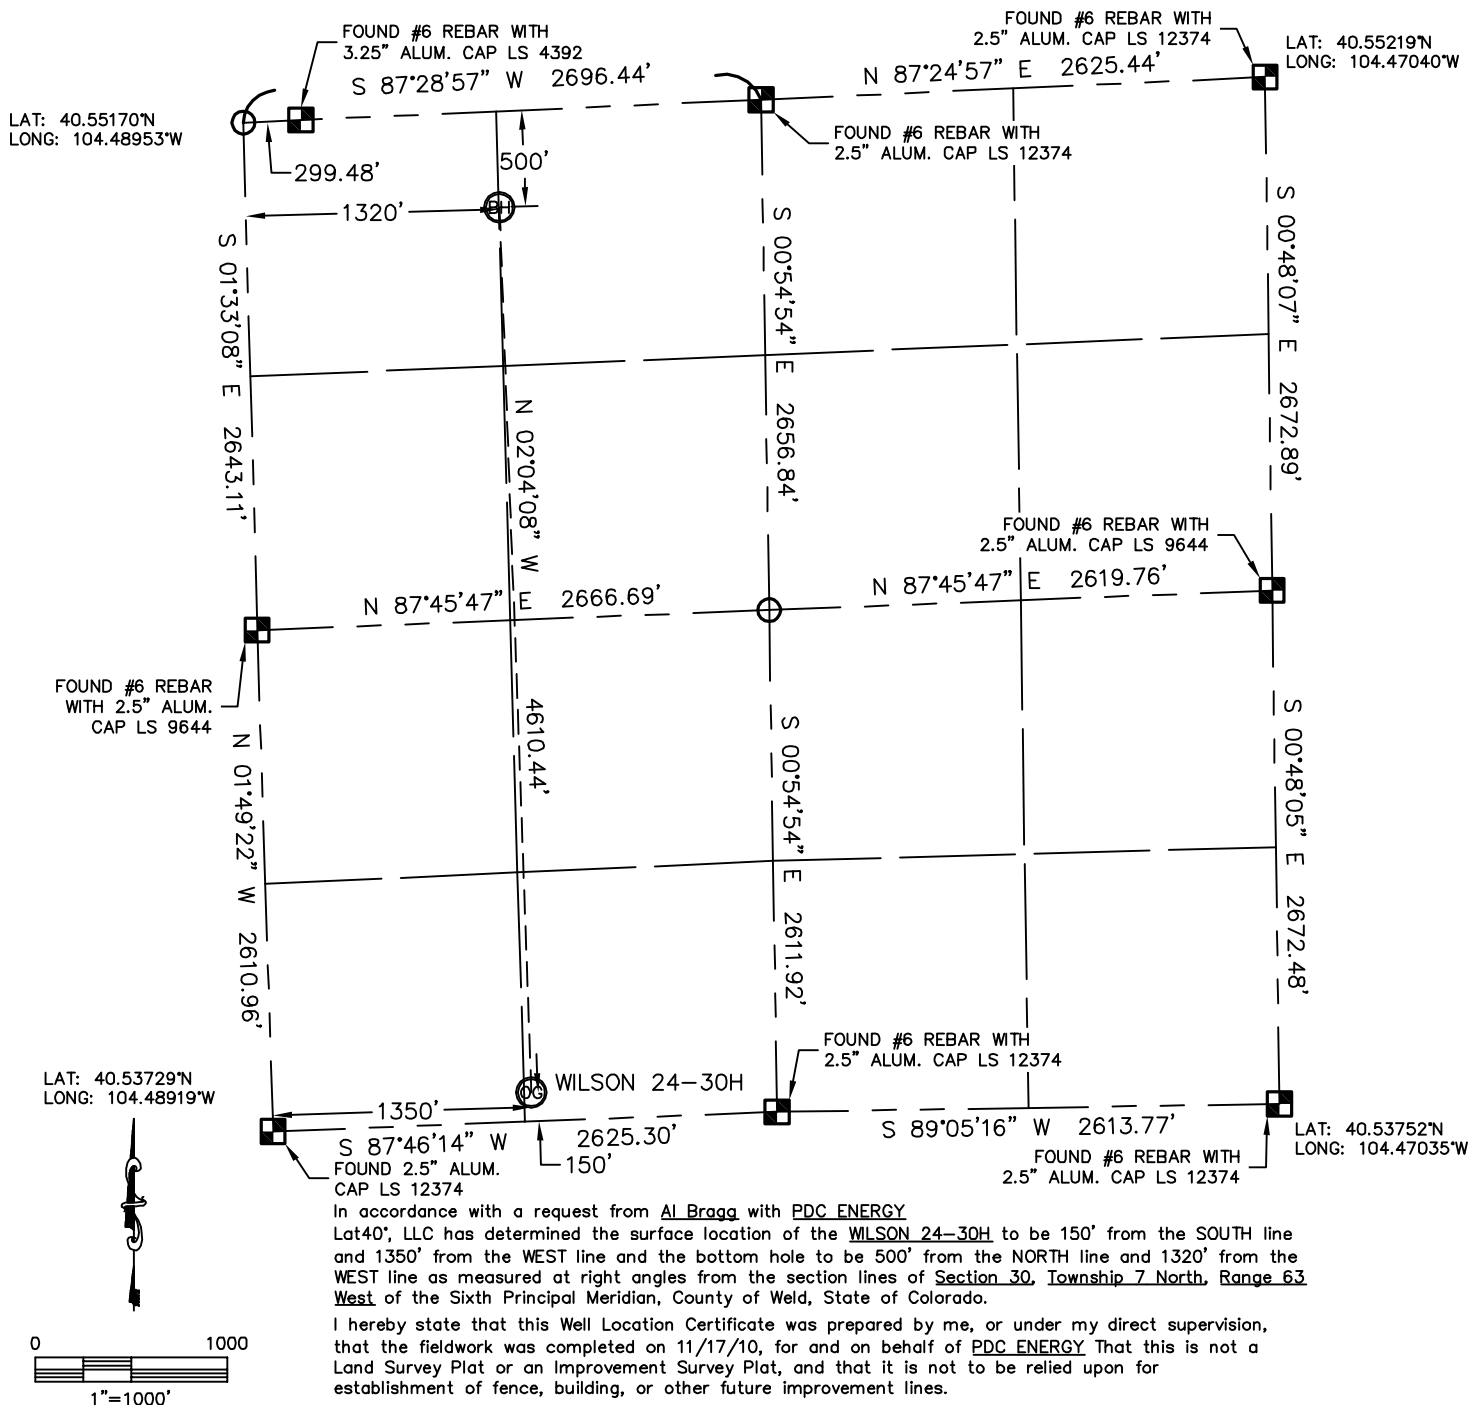

NOTE:

- 1) Bearings shown are Grid Bearings of the Colorado State Plane Coordinate System, North Zone, North American Datum 1983/2007. The lineal dimensions as contained herein are based upon the "U.S. Survey Foot."
- 2) Ground elevations are based on an observed GPS elevation (NAVD 1988 DATUM).
- 3) IMPROVEMENTS: See LOCATION DRAWING for all visible improvements within 400' of disturbed area.
- 4) SURFACE USE: RANGELAND
- 5) INSTRUMENT OPERATOR: TIM WHELOCK
- 6) EXISTING WELLS MEASURED AT CARDINAL DIRECTIONS FROM THE SURFACE LOCATION

NOTE

According to Colorado law, you must commence any legal action based upon any defect in this W.L.C. within three years after you discover such defect. In no event, may any action based upon any defect in this survey be commenced more than ten years after the date of the certificate shown hereon. (13-80-105 C.R.S.)

LEGEND

- = ALIQUOT MONUMENT AS DESCRIBED
 = CALCULATED POSITION
 = EXISTING WELL HEAD

SURFACE LOCATION

LATITUDE: 40.53780°N
LONGITUDE: 104.48435°W
PDOP: 1.1
ELEV: 4772
1/4,1/4: SE1/4SW1/4
NEAREST PROPERTY LINE: 150' SOUTH

BOTTOM HOLE

LATITUDE: 40.55045°N
LONGITUDE: 104.48476°W

PROJECT#: 2010150