
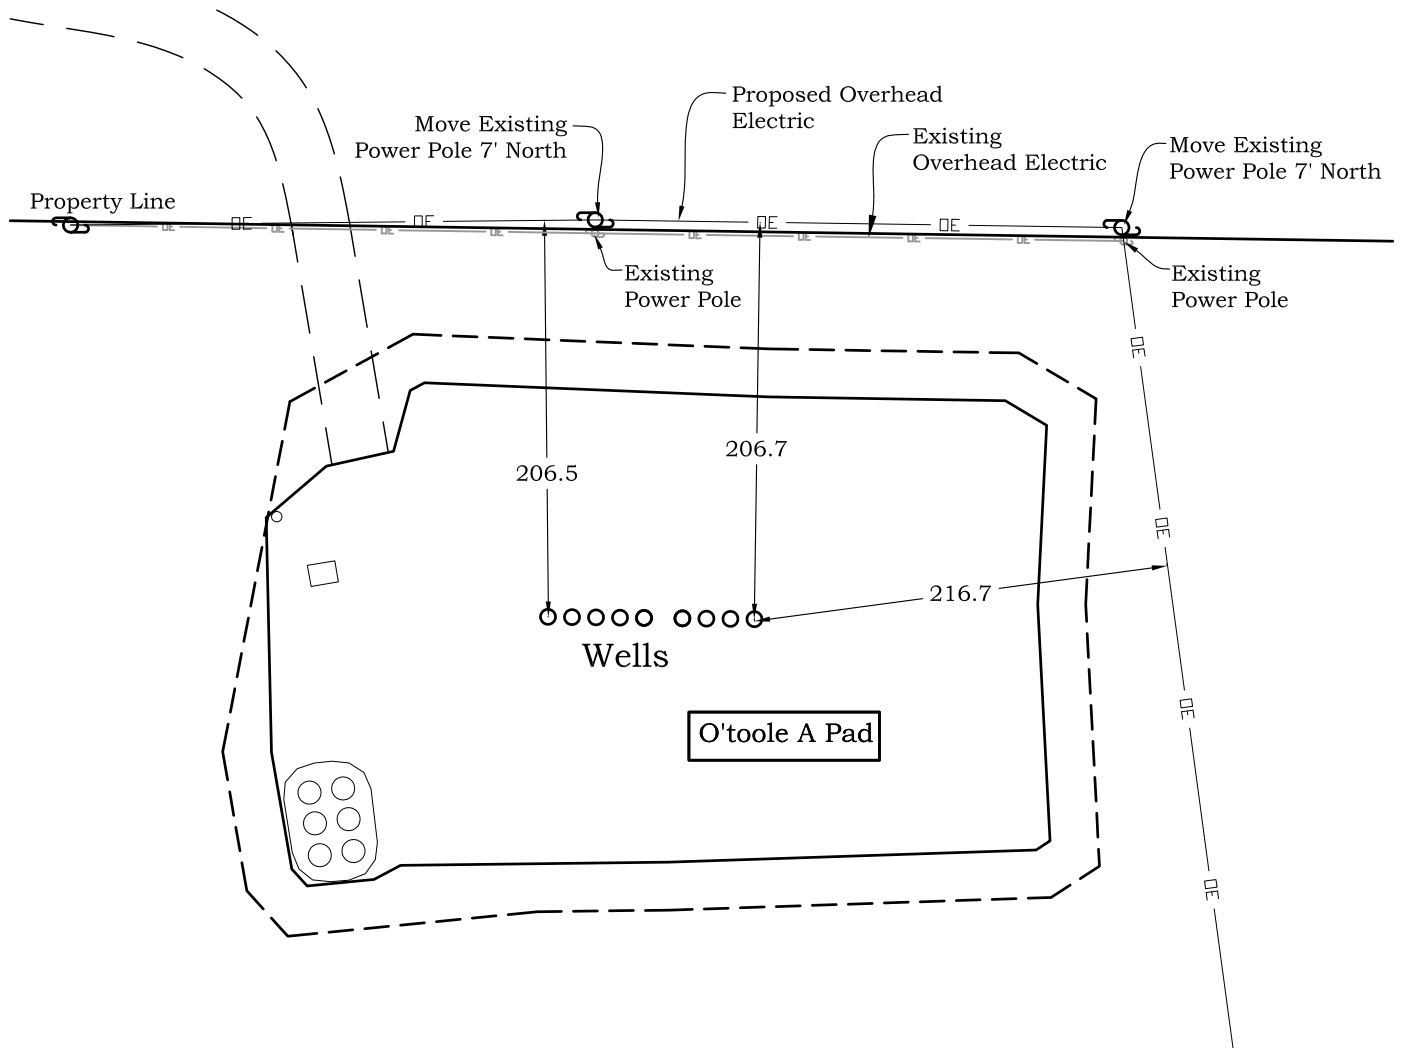


# Power Line Exhibit

## O'Toole A Pad

### Section 16, Township 6 South, Range 92 West

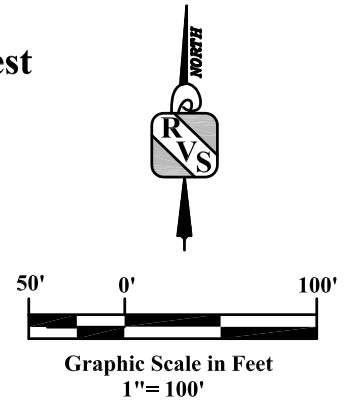

**River Valley Survey, Inc.**  
110 East 3rd. Street, Suite 207  
Rifle, Colorado 81650  
Ph: 970-379-7846

**Project:** O'toole A Pad

**Field Date:** 12-27-10

**Date:** 02-04-11

**Proj. No.** 06001-08

**Scale:** 1"= 100'

**Sheet:** 1 of 1

**Power Line Exhibit**  
**Prepared For Antero Resources**

**Situate In:**  
SE1/4SE1/4 Section 16, T6S., R. 92 W.  
of the 6th P.M., Garfield County,  
Colorado

