


# WELL LOCATION FOR WHITING OIL AND GAS CORPORATION

TWO MILE CREEK 22-13H

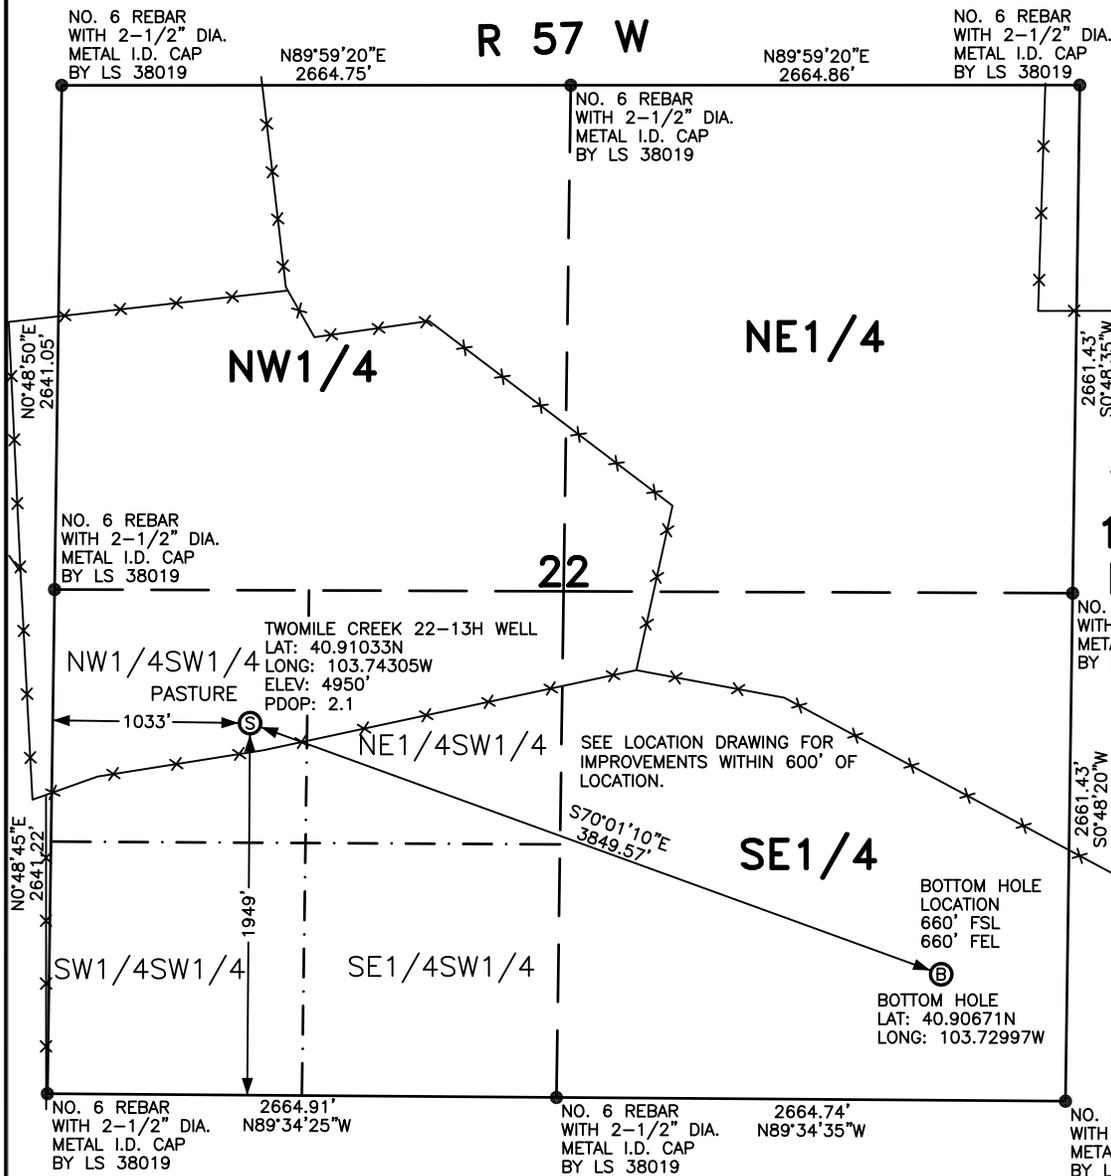

**NOTES**  
BEARINGS SHOWN HEREON ARE BASED UPON RTK GPS OBSERVATIONS

SEE LOCATION DRAWING FOR IMPROVEMENTS WITHIN 600' OF LOCATION.

USGS QUAD MAP:  
BATTLE CANYON, COLO.


LAT/LONG VALUES ARE NAD83  
ELEVATIONS BASED UPON NGS OPLUS SOLUTION NAVD 88 DATUM

ALL DISTANCES TO SECTION LINES ARE MEASURED PERPENDICULAR TO AND ARE AT RIGHT ANGLES TO SAID SECTION LINES.

CALCULATED DIMENSIONS ARE IN PARENTHESES

**LEGEND**

- ⊙ FIELD SURVEYED WELL LOCATION
- ⊕ FIELD SURVEYED BOTTOM HOLE LOCATION
- == == == ROAD
- x-x- FENCE

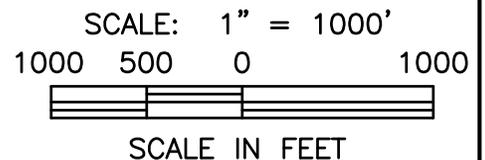

THIS WELL LOCATION PLAT HAS BEEN PREPARED FOR WHITING OIL AND GAS CORPORATION, TO LOCATE THE TWO MILE CREEK 22-13H WELL BEING 1033 FEET FROM THE WEST LINE AND 1949 FEET FROM THE SOUTH LINE IN THE NW1/4SW1/4 OF SECTION 22, TOWNSHIP 11 NORTH, RANGE 57 WEST OF THE 6TH P.M., WELD COUNTY, COLORADO. THE SURFACE ELEVATION AT THIS POINT IS 4950 FEET. THIS IS NOT A LAND SURVEY PLAT.



**LEIBERT-McATEE & ASSOCIATES, INC.**

P.O. BOX 442 615 SOUTH TENTH AVENUE  
STERLING, CO 80751 970-522-1960

FIELD DATE: 9-17-10	DWG DATE: 10-8-10	GPS OPERATOR: DARREN VEAL
TWOMILE CREEK 22-13H	DWG NO. 1130-10	SHEET 1 OF 1