

T11N, R63W, 6th P.M.

EOG RESOURCES, INC.

2010 UELS Alum.
Cap Lat: 40.915125°
Long: 104.428467°

N89°41'01"E - 2621.60' (Meas.)

N89°36'50"E - 2620.76' (Meas.)

2010 UELS Alum.
Cap Lat: 40.915169°
Long: 104.418983°

504'

504'

CRITTER CREEK #18-22H
(As-Built)
Elev. Graded Ground = 5238'

500°31'16"E - 2642.31' (Meas.)

2010 UELS Alum. Cap
Buried 0.8' Deep
Lat: 40.907972°
Long: 104.409414°

22

LINE TABLE		
LINE	BEARING	LENGTH
L1	S45°23'06"E	709.12'

500°32'12"E - 2635.24' (Meas.)

1921 Brass Cap 1.3'
Below Road
Lat: 40.900656°
Long: 104.428408°


S89°41'20"W - 2639.06' (Meas.)

S89°42'16"W - 2639.45' (Meas.)

1921 Brass Cap
1.0' High
Lat: 40.900700°
Long: 104.418867°

2010 UELS Alum. Cap
0.5' Below Ground
Lat: 40.900742°
Long: 104.409319°

N00°08'10"W - 5273.13' (Meas.)

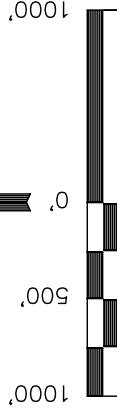

S C A L E

CERTIFICATE

THIS IS TO CERTIFY THAT THE ABOVE PLAT WAS PREPARED FROM FIELD NOTES OF ACTUAL SURVEYS MADE BY ME OR UNDER MY SUPERVISION AND THAT THE SAME ARE TRUE AND CORRECT TO THE BEST OF MY KNOWLEDGE AND BELIEF.

REGISTERED LAND SURVEYOR
REGISTRATION NO. 17490
STATE OF COLORADO

UINTAH ENGINEERING & LAND SURVEYING
85 SOUTH 200 EAST - VERNAL, UTAH 84078
(435) 789-1017

PDOP = 2.2

NAD 83 (SURFACE LOCATION)

LATITUDE = 40°54'49.56" (40.913767)
LONGITUDE = 104°25'35.93" (104.426647)

NAD 27 (SURFACE LOCATION)

LATITUDE = 40°54'49.62" (40.913783)
LONGITUDE = 104°25'34.09" (104.426136)

STATE PLANE NAD 83

N: 1577532.53 E: 3296666.97

STATE PLANE NAD 27

N: 577530.57 E: 2296816.37

LEGEND:

— = 90° SYMBOL

● = PROPOSED WELL HEAD.

▲ = SECTION CORNERS LOCATED.

SCALE 1" = 1000'

DATE SURVEYED: 01-12-11

DATE DRAWN: 02-09-11

REFERENCES

G.L.O. PLAT

WEATHER

COOL

FILE

EOG RESOURCES, INC.

Well location, CRITTER CREEK #18-22H, (As-Built) located as shown in the NW 1/4 NW 1/4 of Section 22, T11N, R63W, 6th P.M., Weld County, Colorado.

BASIS OF ELEVATION

SPOT ELEVATION AT THE NORTHEAST CORNER OF SECTION 1, T11N, R63W, 6th P.M. TAKEN FROM THE HEREFORD, QUADRANGLE, COLORADO, WELD COUNTY, 7.5 MINUTE QUAD (TOPOGRAPHIC MAP) PUBLISHED BY THE UNITED STATES DEPARTMENT OF THE INTERIOR, GEOLOGICAL SURVEY. SAID ELEVATION IS MARKED AS BEING 5352 FEET.

BASIS OF BEARINGS

BASIS OF BEARINGS IS A G.P.S. OBSERVATION.