


WELL LOCATION CERTIFICATE

THIS MAP DOES NOT REPRESENT A BOUNDARY SURVEY

SECTION: 15
TOWNSHIP: 5N
RANGE: 63W

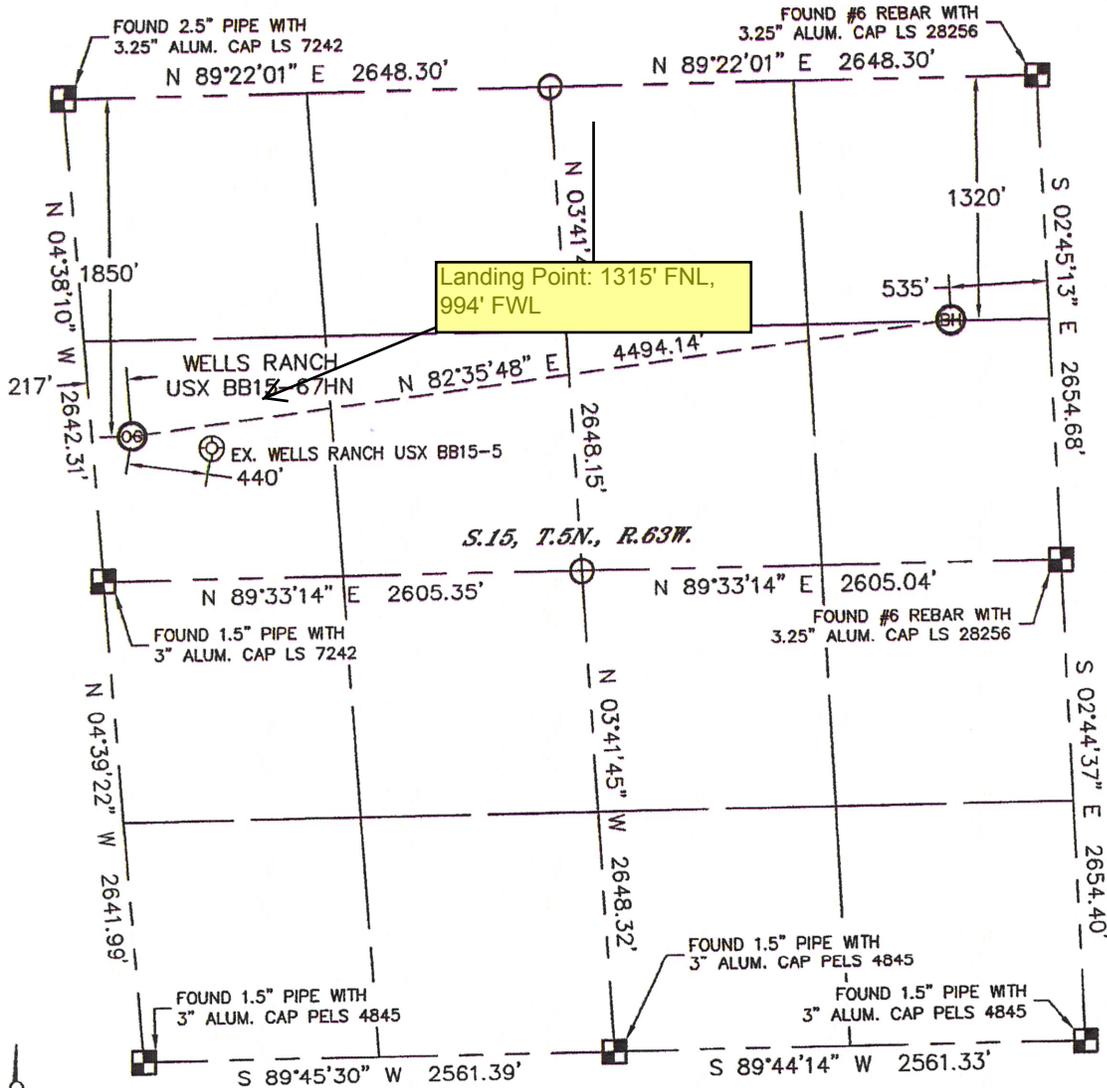

In accordance with a request from Sean Casper with Noble Energy Inc. Lat40°, LLC has determined the surface location of the WELLS RANCH USX BB15-67HN to be 1850' from the NORTH line and 217' from the WEST line and the bottom hole to be 1320' from the NORTH line and 535' from the EAST line as measured at right angles from the section lines of Section 15, Township 5 North, Range 63 West of the Sixth Principal Meridian, County of Weld, State of Colorado.

I hereby state that this Well Location Certificate was prepared by me, or under my direct supervision, that the fieldwork was completed on 12/21/10, for and on behalf of Noble Energy Inc. That this is not a Land Survey Plat or an Improvement Survey Plat, and that it is not to be relied upon for establishment of fence, building, or other future improvement lines.

NOTE:

- 1) Bearings shown are Grid Bearings of the Colorado State Plane Coordinate System, North Zone, North American Datum 1983/2007. The lineal dimensions as contained herein are based upon the "U.S. Survey Foot."
- 2) Ground elevations are based on an observed GPS elevation (NAVD 1988 DATUM).
- 3) NEAREST EXISTING WELL: WELLS RANCH USX BB15-5, 440'
- 4) IMPROVEMENTS: See LOCATION DRAWING for all visible improvements within 400' of disturbed area.
- 5) SURFACE USE: RANGELAND
- 6) INSTRUMENT OPERATOR: AARON LUND


NOTE

According to Colorado law, you must commence any legal action based upon any defect in this W.L.C. within three years after you discover such defect. In no event, may any action based upon any defect in this survey be commenced more than ten years after the date of the certificate shown hereon. (13-80-105 C.R.S.)

LEGEND

-  = ALIQUOT MONUMENT AS DESCRIBED
-  = CALCULATED POSITION

SURFACE LOCATION	BOTTOM HOLE
LATITUDE: 40.40156°N	LATITUDE: 40.40300°N
LONGITUDE: 104.43121°W	LONGITUDE: 104.41519°W
PDOP: 2.4	
ELEV: 4665'	
1/4, 1/4: SW1/4NW1/4	
NEAREST PROPERTY LINE: 217' WEST	

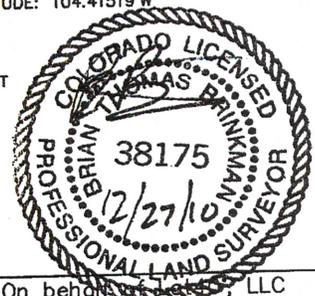


Brian T. Brinkman—On behalf of Lat40°, LLC
Colorado Licensed Professional
Land Surveyor No. 38175 PROJECT#: 2010181

SITE SKETCH

WELLS RANCH USX BB15-67HN

SECTION: 15
TOWNSHIP: 5N
RANGE: 63W

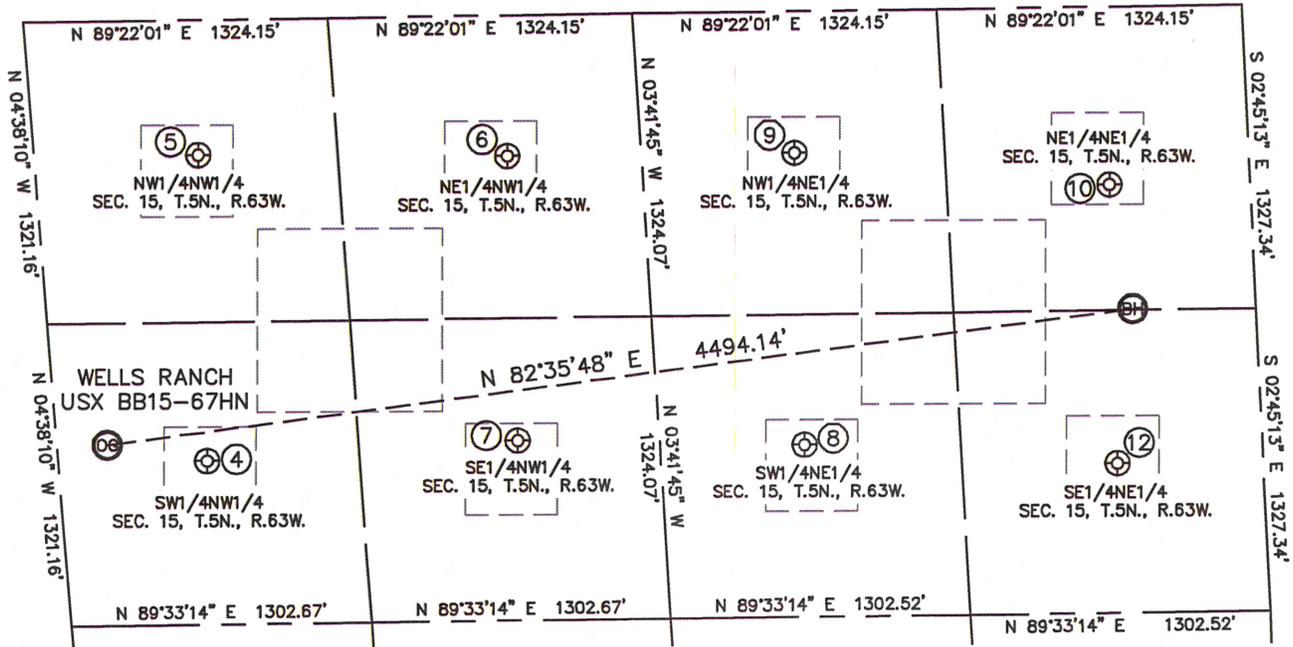

④
WELLS RANCH
USX BB 15-5
SW1/4NW1/4
1925' FNL
644' FWL
LAT-40.40135°N
LONG-104.42966°W
PDOP: 3.2
ELEV: 4679'

⑤
WELLS RANCH
USX BB 15-4
NW1/4NW1/4
590' FNL
711' FWL
LAT-40.40502°N
LONG-104.42974°W
PDOP: 2.1
ELEV: 4677'

⑥
WELLS RANCH
USX BB 15-3
NE1/4NW1/4
614' FNL
2048' FWL
LAT-40.40495°N
LONG-104.42493°W
PDOP: 2.1
ELEV: 4687'

⑦
WELLS 22-15
SE1/4NW1/4
1857' FNL
1995' FWL
LAT-40.40154°N
LONG-104.42481°W
PDOP: 1.2
ELEV: 4675'

⑧
WELLS RANCH
USX BB 15-7
SW1/4NE1/4
1895' FNL
1987' FEL
LAT-40.40143°N
LONG-104.42033°W
PDOP: 1.8
ELEV: 4650'

⑨
WELLS 31-15
NW1/4NE1/4
620' FNL
1971' FEL
LAT-40.40493°N
LONG-104.42044°W
PDOP: 1.2
ELEV: 4658'

⑩
WELLS RANCH
USX BB 15-1
NE1/4NE1/4
778' FNL
611' FEL
LAT-40.40449°N
LONG-104.41553°W
PDOP: 1.1
ELEV: 4658'

⑫
WELLS 42-15
SE1/4NE1/4
1996' FNL
633' FEL
LAT-40.40114°N
LONG-104.41545°W
PDOP: 3.4
ELEV: 4648'

