


# TOPOGRAPHY / HYDROLOGY MAP

SEC. 32 T7N R66W, 6TH P.M.

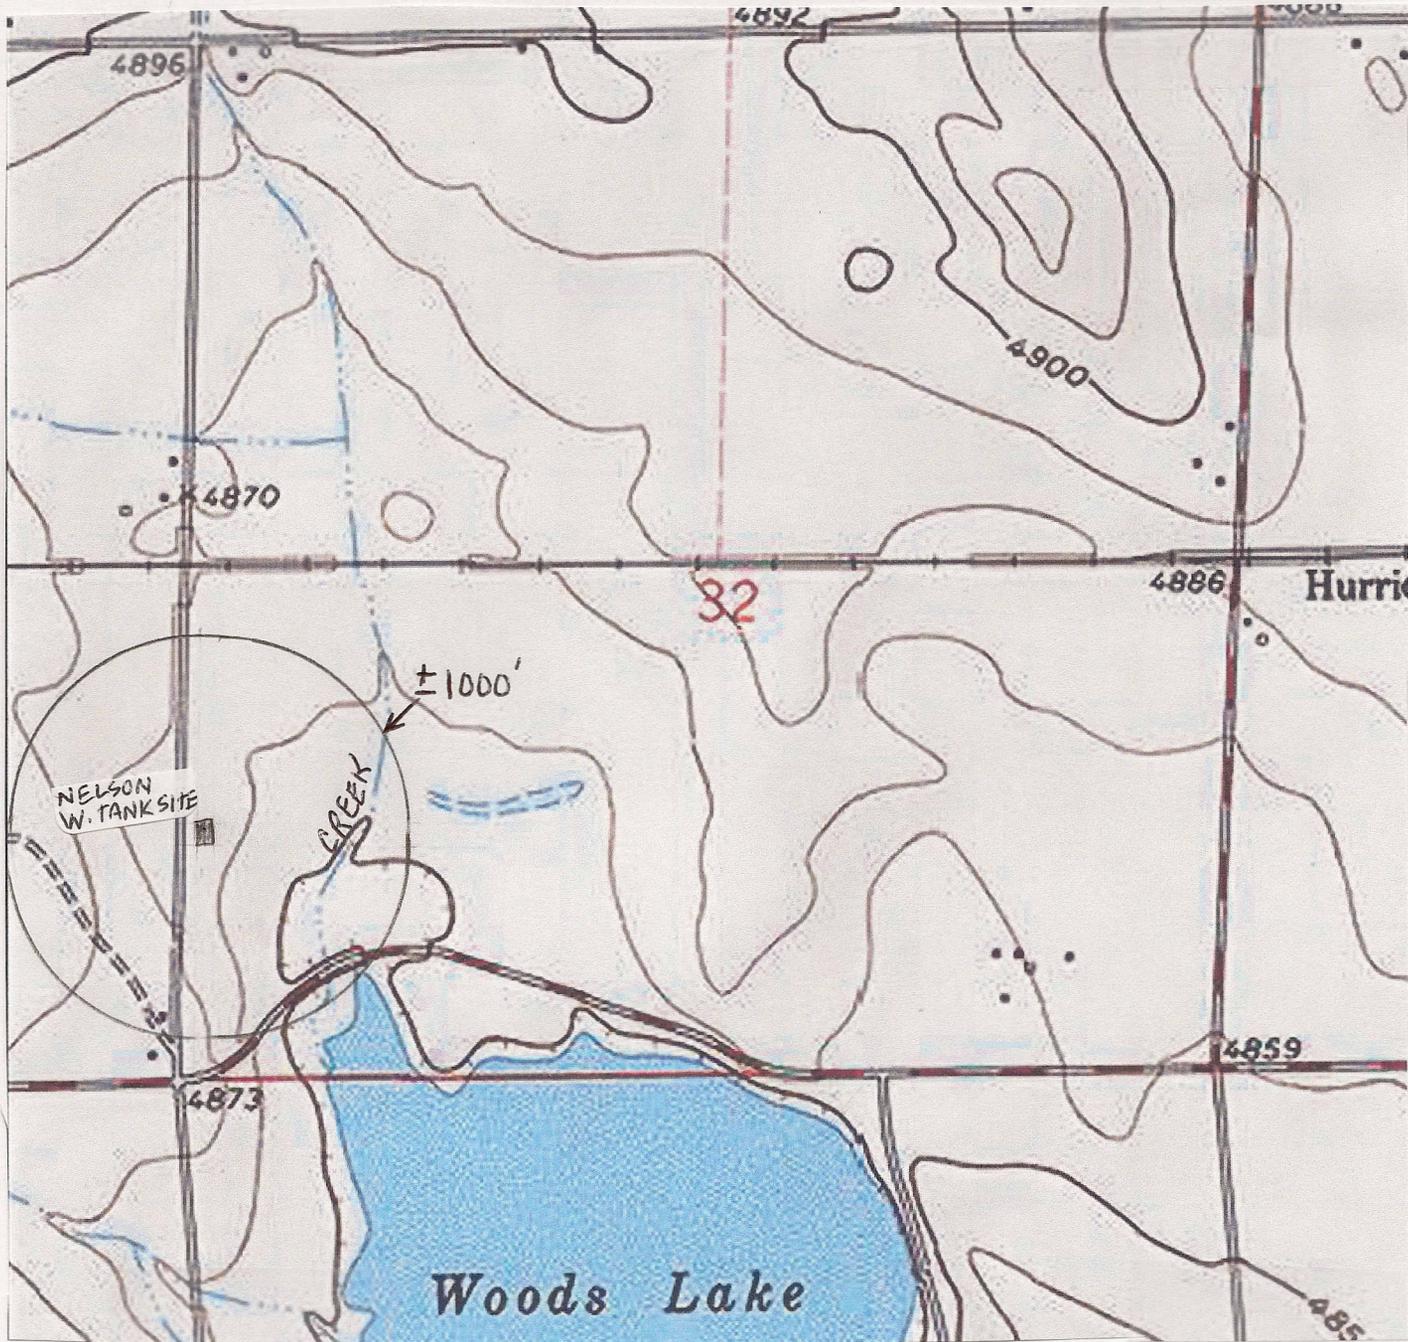

THE TOP OF THE WEST CREEK BANK WHICH  
DRAINS TO WOOD LAKE IS 670' SE OF TANK SITE.  
IT IS APPROXIMATELY 950' SE TO THE WATERS EDGE OF LAKE.  
NO OTHER WATER FEATURES WITHIN 1000'.



**NORTH**



SCALE 1" = 1000'

PREPARED BY:

HORSESHOE SURVEYING, LLC  
PO BOX 150458  
LAKEWOOD, CO 80215  
(720)872-0196

WELL NAME:

NELSON W. TANK SITE

DRAWING DATE:

12-13-10

LOCATION:

WELD COUNTY, CO  
SW1/4, SEC. 32, T7N, R66W, 6TH P.M.

FIELD DATE:

12-12-10

BY:

TGC