


WELL LOCATION CERTIFICATE

THIS MAP DOES NOT REPRESENT A BOUNDARY SURVEY

SECTION: 14
TOWNSHIP: 4N
RANGE: 64W

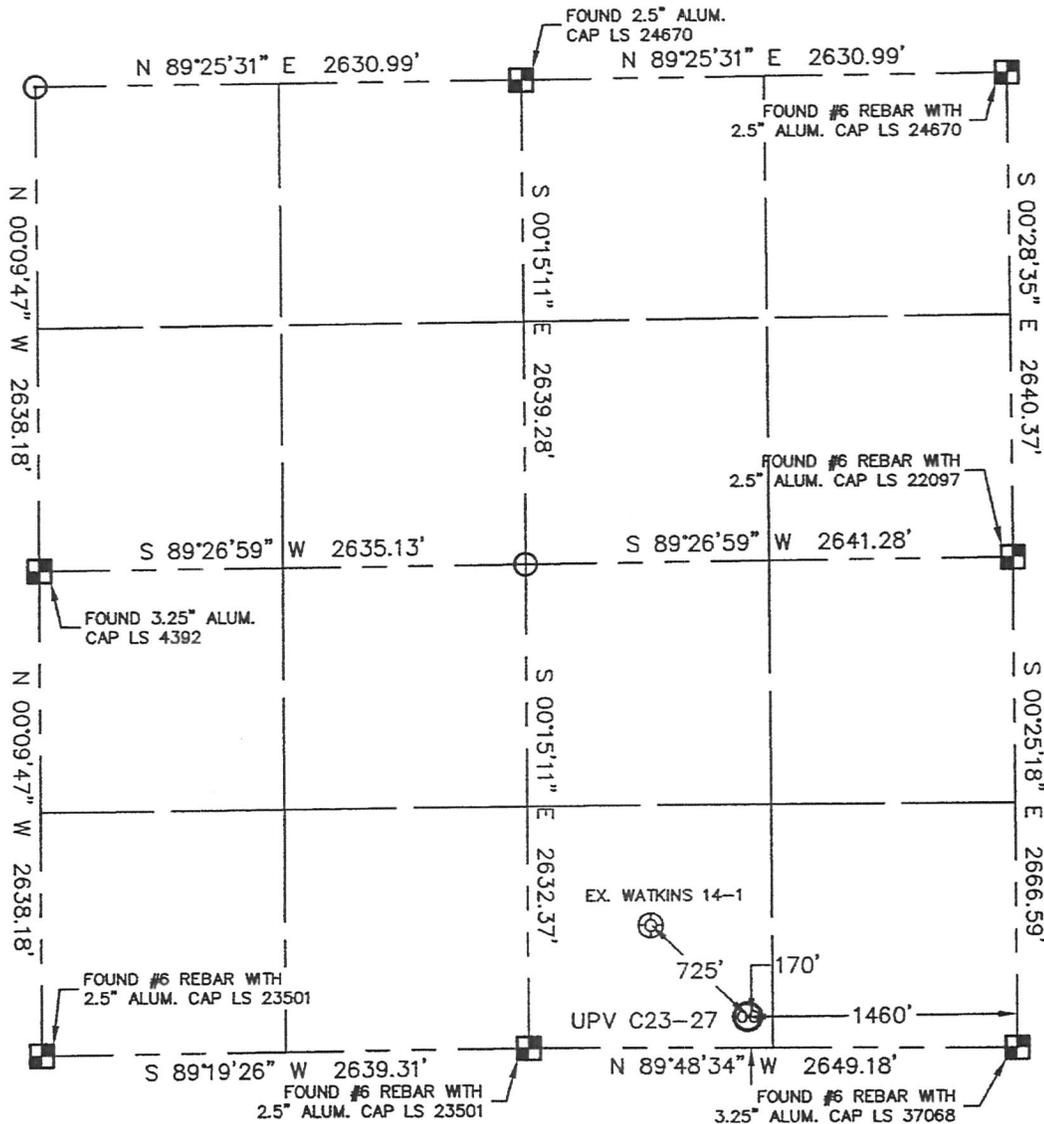

In accordance with a request from MATT CAMPBELL with Noble Energy Inc. Lat40°, LLC has determined the surface location of the UPV C23-27 to be 170' from the SOUTH line and 1460' from the EAST line as measured at right angles from the section line of Section 14, Township 4 North, Range 64 West of the Sixth Principal Meridian, County of Weld, State of Colorado.

I hereby state that this Well Location Certificate was prepared by me, or under my direct supervision, that the fieldwork was completed on 8/24/10, for and on behalf of Noble Energy Inc. That this is not a Land Survey Plat or an Improvement Survey Plat, and that it is not to be relied upon for establishment of fence, building, or other future improvement lines.

NOTE:

- 1) Bearings shown are Grid Bearings of the Colorado State Plane Coordinate System, North Zone, North American Datum 1983/2007. The lineal dimensions as contained herein are based upon the "U.S. Survey Foot."
- 2) Ground elevations are based on an observed GPS elevation (NAVD 1988 DATUM).
- 3) NEAREST EXISTING WELL: WATKINS 14-1 725'
- 4) IMPROVEMENTS: See LOCATION DRAWING for all visible improvements within 400' of disturbed area.
- 5) SURFACE USE: CROP IRRIGATED
- 6) INSTRUMENT OPERATOR: BRIAN BRINKMAN

SURFACE LOCATION

LATITUDE: 40.305657N
LONGITUDE: 104.513647W
PDOP: 1.4
ELEV: 4648
1/4,1/4: SW1/4SE1/4
NEAREST PROPERTY LINE: 170' SOUTH



NOTE

According to Colorado law, you must commence any legal action based upon any defect in this W.L.C. within three years after you discover such defect. In no event, may any action based upon any defect in this survey be commenced more than ten years after the date of the certificate shown hereon. (13-80-105 C.R.S.)

LEGEND

- = ALIQUOT MONUMENT AS DESCRIBED
- = CALCULATED POSITION


Brian T. Brinkman—On behalf of Lat40°, LLC
Colorado Licensed Professional
Land Surveyor No. 38175

PROJECT#: 2010058

SITE SKETCH

UPV C23-27

SECTION: 14
TOWNSHIP: 4N
RANGE: 64W

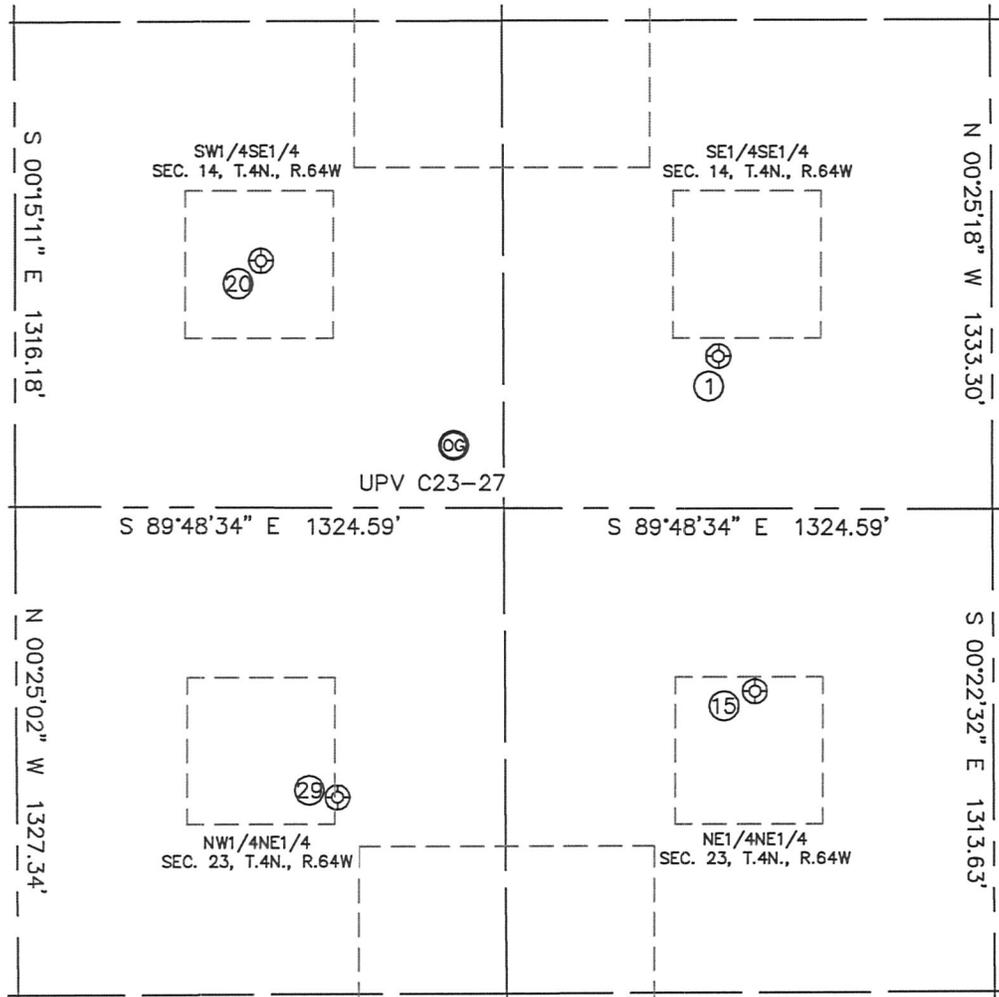

①
WATKINS NO. 14-16
SE1/4SE1/4
415' FSL
741' FEL
LAT-40.30629°N
LONG-104.51105°W
PDOP: 1.5
ELEV: 4650

⑮
UPV 23-114
NE1/4NE1/4
496' FNL
646' FEL
LAT-40.30378°N
LONG-104.51073°W
PDOP: 1.4
ELEV: 4651

⑳
WATKINS 14-1
SW1/4SE1/4
669' FSL
1981' FEL
LAT-40.30704°N
LONG-104.51549°W
PDOP: 1.3
ELEV: 4650

㉑
UPV 23-214
NW1/4NE1/4
788' FNL
1780' FEL
LAT-40.30303°N
LONG-104.51480°W
PDOP: 2.6
ELEV: 4651

