

MC HAGOOD B2 HYDROLOGY MAP

OIL AND GAS WELLS

- Oil and Gas Wells
- ✕ Temporary Point

ROADS AND RRS

- Major Highways


WATER RESOURCES

- Water Wells
- Major Rivers
- Streams


2009_AERIALS_NAIP



SCALE 1 : 6,238

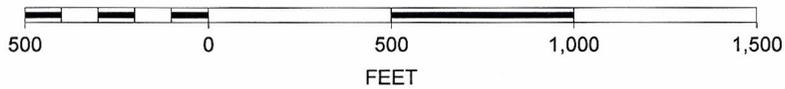

MC Hagood B2 water well & stream map

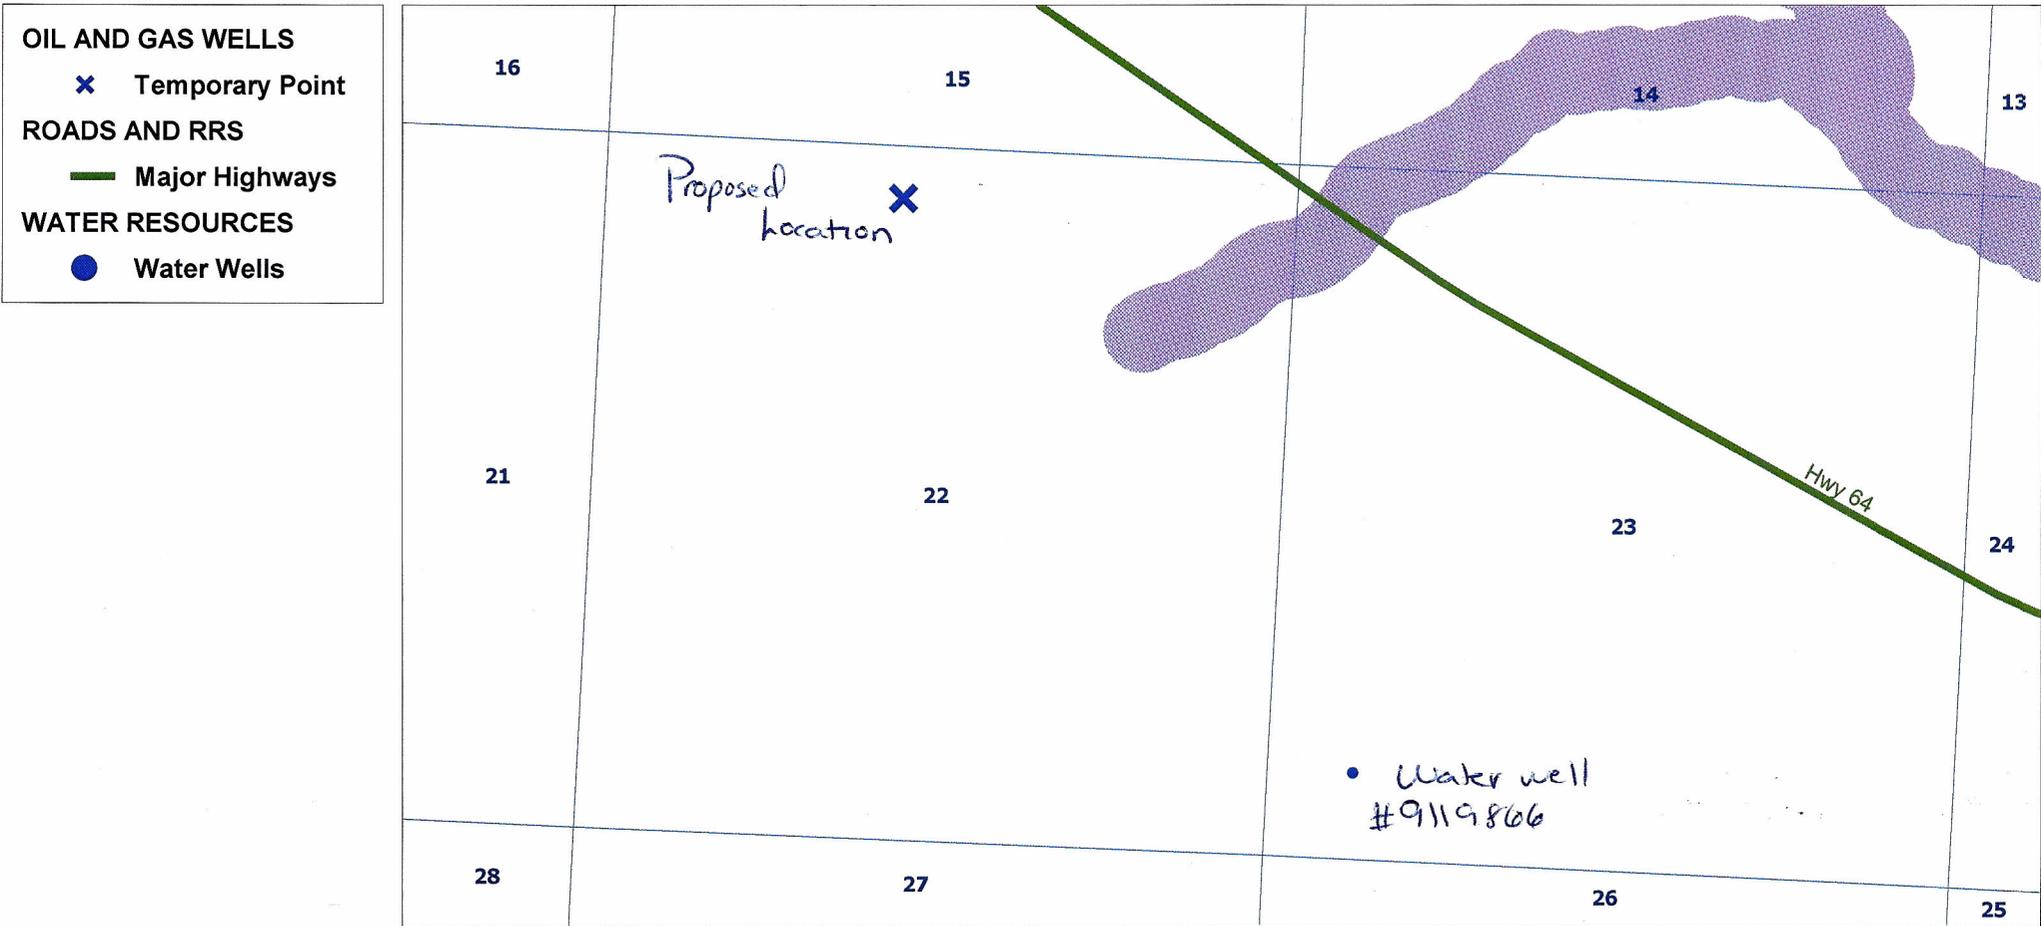

SCALE 1 : 17,531

