


MARATHON OIL CO. RAWHIDE FLATS 10-68-16-1M

LOCATED WITHIN THE NW1/4 SE1/4 SECTION 16 T10N R68W
OF THE 6TH P.M., LARIMER COUNTY, COLORADO

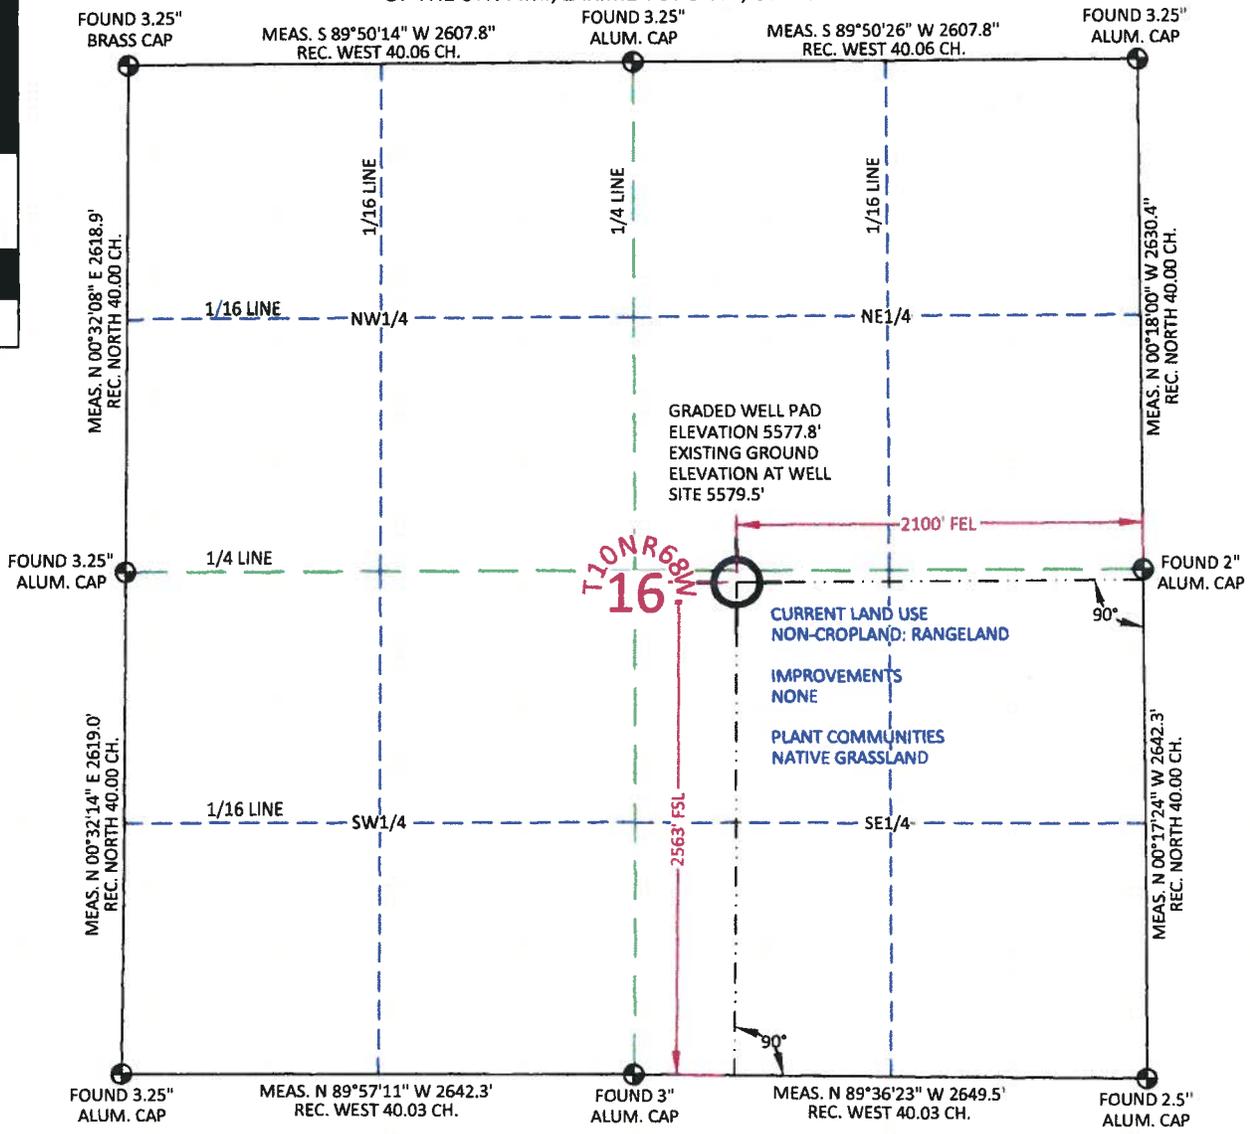

MONITOR WELL LOCATION

GEOGRAPHIC	DEG. DEC.	LAT.	40.833938°
		LONG.	105.007840°
GEOGRAPHIC	DEG. MIN. SEC.	LAT.	40.833956°
		LONG.	105°00'28.22"
STATE PLANE	CO. NORTH	NORTH	1547029.80
		EAST	3136193.50
STATE PLANE	CO. NORTH	NORTH	547027.10
		EAST	2136343.35

I, William H. Dolinar, Professional Land Surveyor, CO. RLS # 38070 hereby certify that (in accordance with a request from Anna Walls with Marathon Oil Co, 5555 San Felipe, Houston, TX 77056) I and or personnel under my direction made a survey on the 22nd day of January 2011, for the Monitoring Well Location and Elevation of Marathon Oil Co. RAWHIDE FLATS 10-68-16-1M being located within the NW1/4 SE1/4 Section 16, T10N R68W, of the 6th P.M., Larimer County, State of Colorado.

- All bearings and distances are **GRID** based on the Colorado State Plane Coordinate System, North Zone, North American Datum 1983 from GPS observations occupying a WHS control point (5/8" rebar) and having the Location and Elevation derived from an Opus Solution.
- Vertical Datum used is of NAVD 88.
- Record Bearings and Distances as shown are based on the General Land Office Survey plat approved on the 16th day of December 1872.



FOOTAGE: 2100' FEL - 2563' FSL
GROUND ELEV. 5579.5'
INST. OPTR. ALEC THOMAS
MEASURE DATE: 12/23/2010
PDOP: 1.826

CONFIDENTIALITY NOTES:
The information contained in this plot is legally privileged and confidential information intended only for the use of the recipients. If you are not the intended recipients, you are hereby notified that any use, dissemination, distribution or copying of this information is strictly prohibited.

WILLIAM H. SMITH & ASSOCIATES P.C.
SURVEYING CONSULTANTS
50 EAST SECOND NORTH GREEN RIVER, WY
PHONE: 307-875-3638
307-875-3639
www.whsmithpc.com

DRAWN BY: CED
PROJECT NO: 1068161M
CHECKED BY: WHD
JOB NO: 2011001

LEGEND

- FOUND CORNER
- ⊗ CALCULATED CORNER
- NOTHING FOUND

LOCATION:
RAWHIDE FLATS 10-68-16-1M
WITHIN THE NW/4
SE/4 SECTION 16,
T 10 N, R 68 W,
6TH PM.
LARIMER COUNTY,
COLORADO

MARATHON OIL COMPANY
PO BOX 3128, HOUSTON TX, 77253
5555 SAN FELIPE, HOUSTON TX, 77056

MONITORING WELL PLAT

SCALE: 1"=1000'
DATE: 01/26/2011
EXHIBIT "A"
SHEET 1 OF 1