


There are no visible improvements within 400 feet of the location.

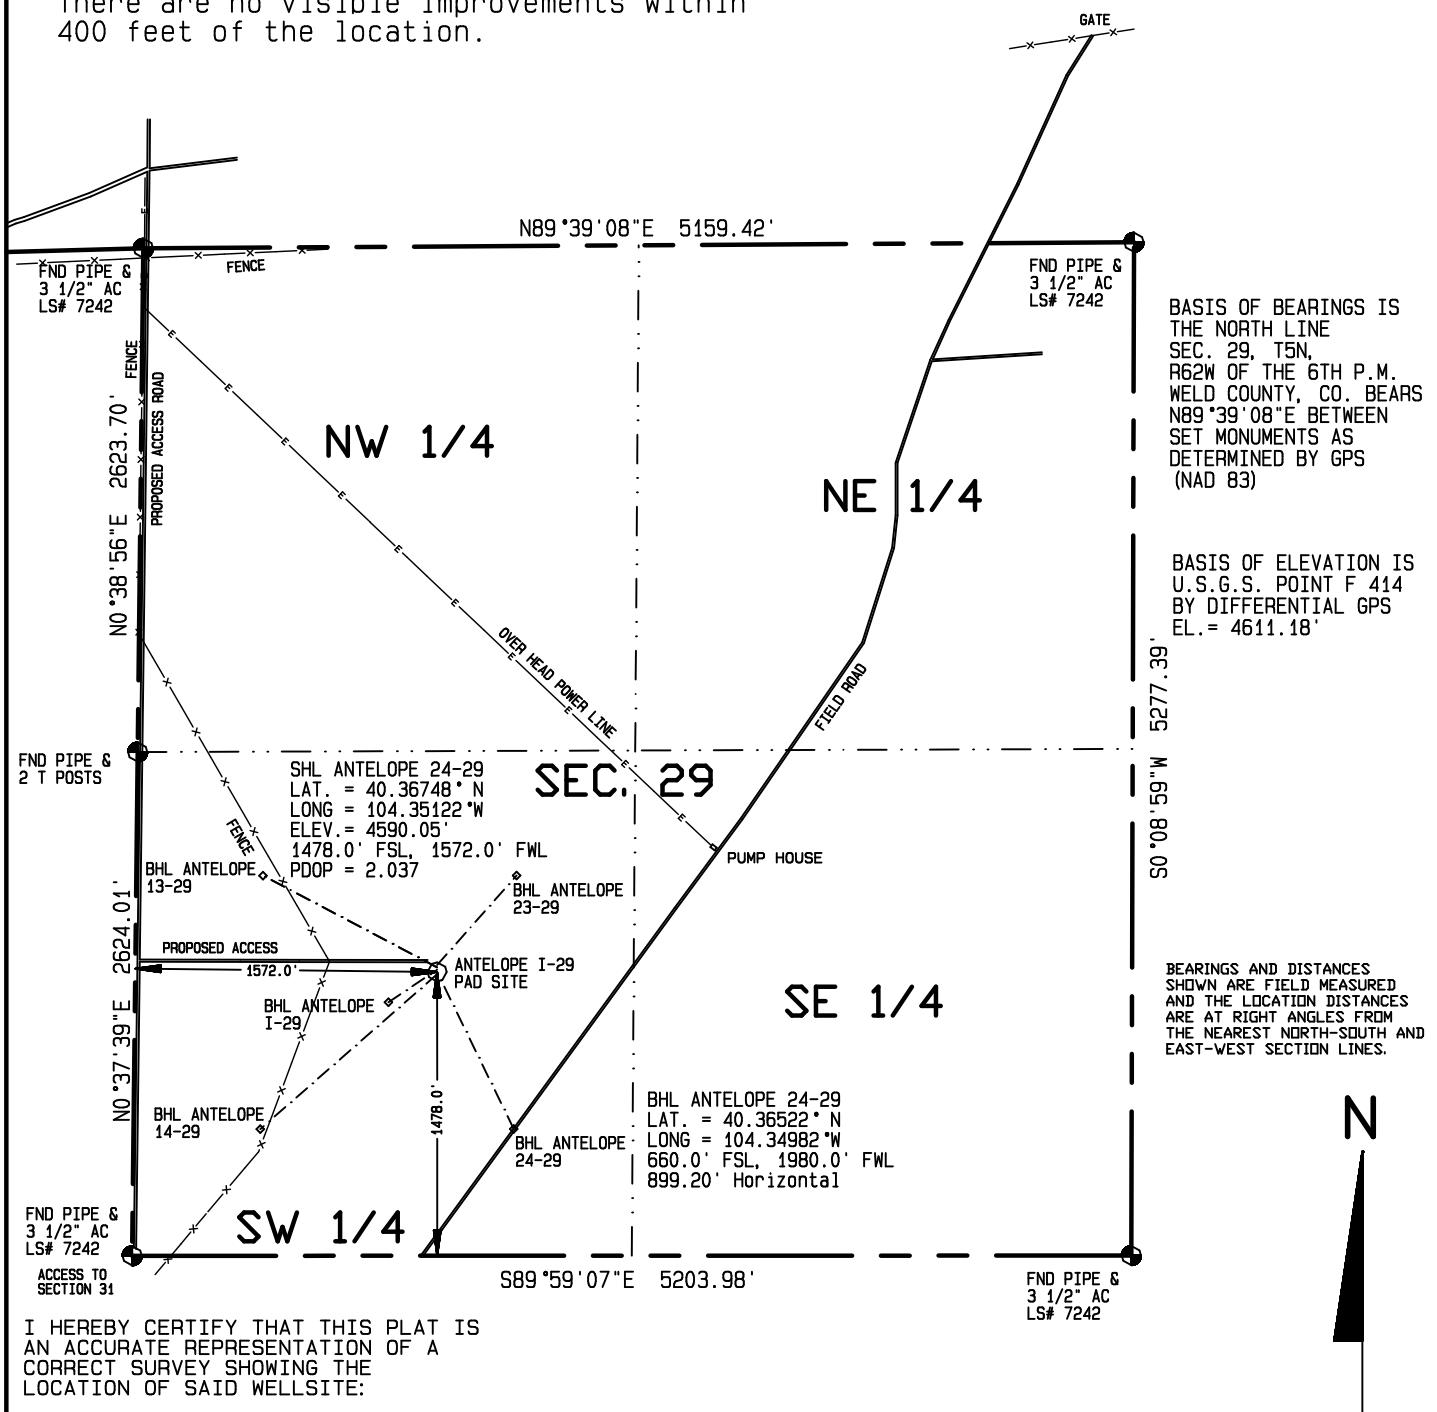

Dan Griggs PLS# 38018

CONTRACT SURVEYORS, LTD.
COMPLETE SURVEYING AND GLOBAL POSITIONING

2133 SOUTH BELLAIRE STREET #14
DENVER COLORADO 80222
(303) 756-3695



MULTIPLE WELL PLAN
PAGE 5

CSL# 11104-07

DATE OF FIELD WORK:

27 JANUARY 2011

DATE OF DRAWING:

7 FEBRUARY 2011

ANTELOPE 24-29 (DIRECTIONAL WELL)

NE 1/4 SW 1/4 SEC. 29, T5N, R62W

BONANZA CREEK ENERGY OPERATING COMPANY, LLC

WELD COUNTY, COLORADO