


## Anadarko, Weld County CO

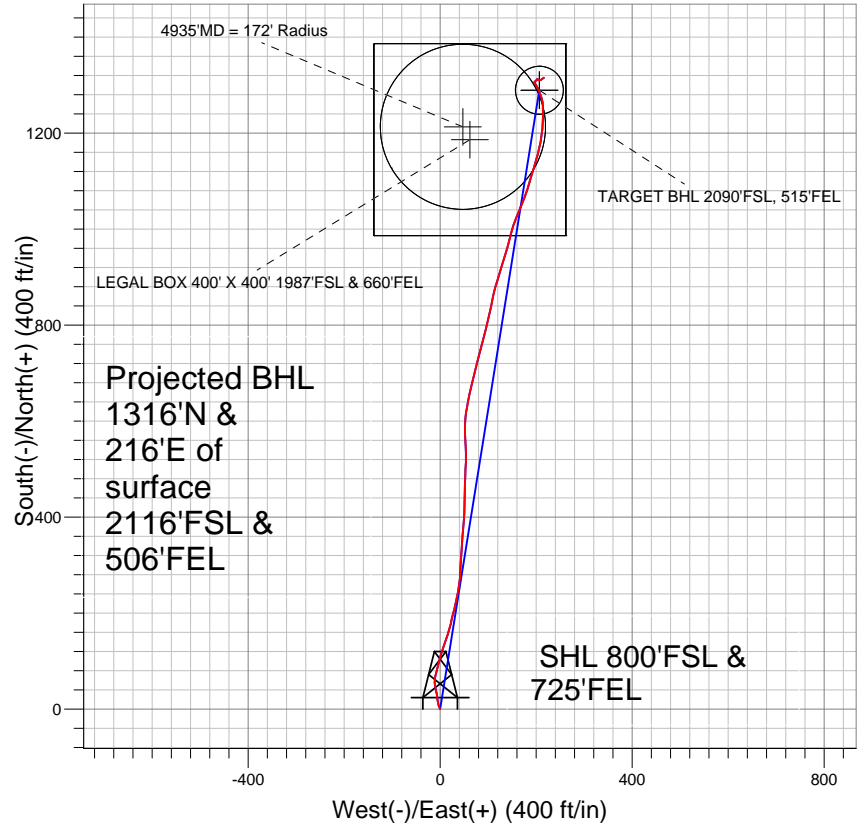


### LEGEND

- Cottonwood 9-33, Wellbore #1, Plan #1 (11-01-10) V0
- Wellbore #1
- Survey #1

## Final Survey Plot

Projected Final Survey -  
8314'MD & 8115'TVD @ 1333' VS  
1.0 deg Inc 46.6 deg AZ

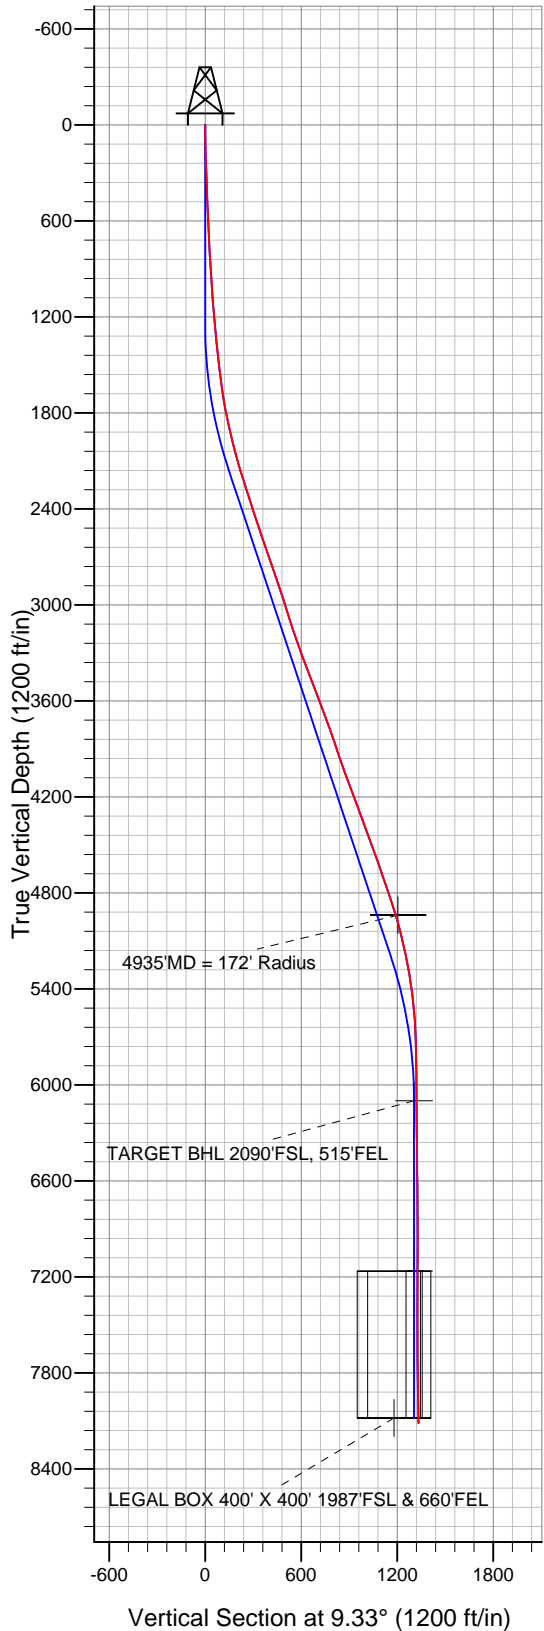

Project: SEC.33-T2N-R66W  
Site: Cottonwood 16-33 Pad Sec.33-T2N-R66W  
Well: Cottonwood 9-33  
Plan: Wellbore #1



## **Anadarko, Weld County CO**

**SEC.33-T2N-R66W**

**Cottonwood 16-33 Pad Sec.33-T2N-R66W**

**Cottonwood 9-33**

**Wellbore #1**

**Survey: Survey #1**

## **Standard Survey Report**

**22 November, 2010**



|                  |                                      |                                     |                                      |
|------------------|--------------------------------------|-------------------------------------|--------------------------------------|
| <b>Company:</b>  | Anadarko, Weld County CO             | <b>Local Co-ordinate Reference:</b> | Well Cottonwood 9-33                 |
| <b>Project:</b>  | SEC.33-T2N-R66W                      | <b>TVD Reference:</b>               | WELL @ 5002.0ft (Original Well Elev) |
| <b>Site:</b>     | Cottonwood 16-33 Pad Sec.33-T2N-R66W | <b>MD Reference:</b>                | WELL @ 5002.0ft (Original Well Elev) |
| <b>Well:</b>     | Cottonwood 9-33                      | <b>North Reference:</b>             | True                                 |
| <b>Wellbore:</b> | Wellbore #1                          | <b>Survey Calculation Method:</b>   | Minimum Curvature                    |
| <b>Design:</b>   | Wellbore #1                          | <b>Database:</b>                    | Landmark                             |

|                    |  |                      |                             |
|--------------------|--|----------------------|-----------------------------|
| <b>Project</b>     | SEC.33-T2N-R66W, Weld County, Colorado |                      |                             |
| <b>Map System:</b> | US State Plane 1983                    | <b>System Datum:</b> | Mean Sea Level              |
| <b>Geo Datum:</b>  | North American Datum 1983              |                      | Using Well Reference Point  |
| <b>Map Zone:</b>   | Colorado Northern Zone                 |                      | Using geodetic scale factor |

|                              |                                      |                          |                   |
|------------------------------|--------------------------------------|--------------------------|-------------------|
| <b>Site</b>                  | Cottonwood 16-33 Pad Sec.33-T2N-R66W |                          |                   |
| <b>Site Position:</b>        |                                      | <b>Northing:</b>         | 1,276,292.40 ft   |
| <b>From:</b>                 | Lat/Long                             | <b>Easting:</b>          | 3,202,778.35 ft   |
| <b>Position Uncertainty:</b> | 0.0 ft                               | <b>Slot Radius:</b>      | "                 |
|                              |                                      | <b>Latitude:</b>         | 40° 5' 22.340 N   |
|                              |                                      | <b>Longitude:</b>        | 104° 46' 30.824 W |
|                              |                                      | <b>Grid Convergence:</b> | 0.47 °            |

|                             |                 |                            |                   |
|-----------------------------|-----------------|----------------------------|-------------------|
| <b>Well</b>                 | Cottonwood 9-33 |                            |                   |
| <b>Well Position</b>        | <b>+N/-S</b>    | 0.0 ft                     | <b>Northing:</b>  |
|                             | <b>+E/-W</b>    | 0.0 ft                     | <b>Easting:</b>   |
| <b>Position Uncertainty</b> | 0.0 ft          | <b>Wellhead Elevation:</b> | ft                |
|                             |                 | <b>Latitude:</b>           | 40° 5' 22.340 N   |
|                             |                 | <b>Longitude:</b>          | 104° 46' 31.033 W |
|                             |                 | <b>Ground Level:</b>       | 4,987.0 ft        |

|                  |                   |                    |                        |                      |                            |
|------------------|-------------------|--------------------|------------------------|----------------------|----------------------------|
| <b>Wellbore</b>  | Wellbore #1       |                    |                        |                      |                            |
| <b>Magnetics</b> | <b>Model Name</b> | <b>Sample Date</b> | <b>Declination (°)</b> | <b>Dip Angle (°)</b> | <b>Field Strength (nT)</b> |
|                  | IGRF2010          | 11/1/2010          | 8.93                   | 66.82                | 53,031                     |

|                          |                              |                   |                   |                      |     |
|--------------------------|------------------------------|-------------------|-------------------|----------------------|-----|
| <b>Design</b>            | Wellbore #1                  |                   |                   |                      |     |
| <b>Audit Notes:</b>      |                              |                   |                   |                      |     |
| <b>Version:</b>          | 1.0                          | <b>Phase:</b>     | ACTUAL            | <b>Tie On Depth:</b> | 0.0 |
| <b>Vertical Section:</b> | <b>Depth From (TVD) (ft)</b> | <b>+N/-S (ft)</b> | <b>+E/-W (ft)</b> | <b>Direction (°)</b> |     |
|                          | 0.0                          | 0.0               | 0.0               | 9.33                 |     |

|                       |                |                          |                  |                    |  |
|-----------------------|----------------|--------------------------|------------------|--------------------|--|
| <b>Survey Program</b> | <b>Date</b>    | 11/22/2010               |                  |                    |  |
| <b>From (ft)</b>      | <b>To (ft)</b> | <b>Survey (Wellbore)</b> | <b>Tool Name</b> | <b>Description</b> |  |
| 215.0                 | 8,314.0        | Survey #1 (Wellbore #1)  | MWD              | MWD - Standard     |  |

|                            |                        |                    |                            |                   |                   |                              |                              |                             |                            |  |
|----------------------------|------------------------|--------------------|----------------------------|-------------------|-------------------|------------------------------|------------------------------|-----------------------------|----------------------------|--|
| <b>Survey</b>              |                        |                    |                            |                   |                   |                              |                              |                             |                            |  |
| <b>Measured Depth (ft)</b> | <b>Inclination (°)</b> | <b>Azimuth (°)</b> | <b>Vertical Depth (ft)</b> | <b>+N/-S (ft)</b> | <b>+E/-W (ft)</b> | <b>Vertical Section (ft)</b> | <b>Dogleg Rate (°/100ft)</b> | <b>Build Rate (°/100ft)</b> | <b>Turn Rate (°/100ft)</b> |  |
| 0.0                        | 0.00                   | 0.00               | 0.0                        | 0.0               | 0.0               | 0.0                          | 0.00                         | 0.00                        | 0.00                       |  |
| 215.0                      | 2.60                   | 336.00             | 214.9                      | 4.5               | -2.0              | 4.1                          | 1.21                         | 1.21                        | 0.00                       |  |
| 306.0                      | 2.30                   | 345.70             | 305.8                      | 8.1               | -3.3              | 7.5                          | 0.56                         | -0.33                       | 10.66                      |  |
| 552.0                      | 2.40                   | 352.10             | 551.6                      | 18.0              | -5.2              | 16.9                         | 0.11                         | 0.04                        | 2.60                       |  |
| 800.0                      | 3.30                   | 351.40             | 799.3                      | 30.2              | -7.0              | 28.7                         | 0.36                         | 0.36                        | -0.28                      |  |
| 951.0                      | 3.90                   | 347.40             | 950.0                      | 39.5              | -8.8              | 37.6                         | 0.43                         | 0.40                        | -2.65                      |  |
| 1,031.0                    | 4.20                   | 346.40             | 1,029.8                    | 45.0              | -10.0             | 42.8                         | 0.39                         | 0.38                        | -1.25                      |  |
| 1,126.0                    | 5.00                   | 355.00             | 1,124.5                    | 52.5              | -11.2             | 50.0                         | 1.11                         | 0.84                        | 9.05                       |  |
| 1,221.0                    | 5.40                   | 3.80               | 1,219.1                    | 61.1              | -11.3             | 58.5                         | 0.94                         | 0.42                        | 9.26                       |  |
| 1,317.0                    | 5.80                   | 15.90              | 1,314.7                    | 70.3              | -9.7              | 67.8                         | 1.30                         | 0.42                        | 12.60                      |  |
| 1,412.0                    | 5.90                   | 14.80              | 1,409.2                    | 79.6              | -7.1              | 77.4                         | 0.16                         | 0.11                        | -1.16                      |  |
| 1,507.0                    | 5.60                   | 11.60              | 1,503.7                    | 88.9              | -4.9              | 86.9                         | 0.46                         | -0.32                       | -3.37                      |  |
| 1,602.0                    | 8.30                   | 17.90              | 1,598.0                    | 99.9              | -1.9              | 98.3                         | 2.95                         | 2.84                        | 6.63                       |  |

|                  |                                      |                                     |                                      |
|------------------|--------------------------------------|-------------------------------------|--------------------------------------|
| <b>Company:</b>  | Anadarko, Weld County CO             | <b>Local Co-ordinate Reference:</b> | Well Cottonwood 9-33                 |
| <b>Project:</b>  | SEC.33-T2N-R66W                      | <b>TVD Reference:</b>               | WELL @ 5002.0ft (Original Well Elev) |
| <b>Site:</b>     | Cottonwood 16-33 Pad Sec.33-T2N-R66W | <b>MD Reference:</b>                | WELL @ 5002.0ft (Original Well Elev) |
| <b>Well:</b>     | Cottonwood 9-33                      | <b>North Reference:</b>             | True                                 |
| <b>Wellbore:</b> | Wellbore #1                          | <b>Survey Calculation Method:</b>   | Minimum Curvature                    |
| <b>Design:</b>   | Wellbore #1                          | <b>Database:</b>                    | Landmark                             |

Survey

| Measured Depth (ft)                   | Inclination (°) | Azimuth (°) | Vertical Depth (ft) | +N/-S (ft) | +E/-W (ft) | Vertical Section (ft) | Dogleg Rate (°/100ft) | Build Rate (°/100ft) | Turn Rate (°/100ft) |
|---------------------------------------|-----------------|-------------|---------------------|------------|------------|-----------------------|-----------------------|----------------------|---------------------|
| 1,697.0                               | 8.70            | 12.30       | 1,692.0             | 113.5      | 1.8        | 112.3                 | 0.97                  | 0.42                 | -5.89               |
| 1,792.0                               | 10.60           | 21.80       | 1,785.6             | 128.6      | 6.5        | 128.0                 | 2.60                  | 2.00                 | 10.00               |
| 1,888.0                               | 13.20           | 17.80       | 1,879.5             | 147.3      | 13.2       | 147.4                 | 2.84                  | 2.71                 | -4.17               |
| 1,983.0                               | 13.40           | 13.60       | 1,972.0             | 168.3      | 19.1       | 169.2                 | 1.04                  | 0.21                 | -4.42               |
| 2,078.0                               | 14.60           | 15.90       | 2,064.2             | 190.5      | 25.0       | 192.0                 | 1.39                  | 1.26                 | 2.42                |
| 2,173.0                               | 18.10           | 11.30       | 2,155.3             | 216.5      | 31.1       | 218.7                 | 3.93                  | 3.68                 | -4.84               |
| 2,268.0                               | 17.30           | 12.40       | 2,245.8             | 244.8      | 37.0       | 247.5                 | 0.91                  | -0.84                | 1.16                |
| 2,363.0                               | 18.40           | 3.60        | 2,336.3             | 273.5      | 41.0       | 276.6                 | 3.06                  | 1.16                 | -9.26               |
| 2,458.0                               | 17.10           | 3.90        | 2,426.7             | 302.4      | 42.9       | 305.4                 | 1.37                  | -1.37                | 0.32                |
| 2,548.0                               | 19.70           | 4.20        | 2,512.1             | 330.8      | 44.9       | 333.7                 | 2.89                  | 2.89                 | 0.33                |
| 2,644.0                               | 18.40           | 3.30        | 2,602.9             | 362.0      | 47.0       | 364.9                 | 1.39                  | -1.35                | -0.94               |
| 2,739.0                               | 19.50           | 5.20        | 2,692.7             | 392.8      | 49.3       | 395.6                 | 1.33                  | 1.16                 | 2.00                |
| 2,834.0                               | 18.80           | 0.30        | 2,782.5             | 423.9      | 50.8       | 426.5                 | 1.84                  | -0.74                | -5.16               |
| 2,929.0                               | 19.10           | 1.30        | 2,872.3             | 454.7      | 51.2       | 457.0                 | 0.47                  | 0.32                 | 1.05                |
| 3,024.0                               | 18.10           | 2.90        | 2,962.4             | 485.0      | 52.3       | 487.1                 | 1.18                  | -1.05                | 1.68                |
| 3,120.0                               | 17.10           | 1.50        | 3,053.9             | 514.0      | 53.5       | 515.9                 | 1.13                  | -1.04                | -1.46               |
| 3,215.0                               | 19.10           | 357.10      | 3,144.2             | 543.5      | 53.0       | 544.9                 | 2.55                  | 2.11                 | -4.63               |
| 3,310.0                               | 19.80           | 358.00      | 3,233.7             | 575.1      | 51.7       | 575.9                 | 0.80                  | 0.74                 | 0.95                |
| 3,405.0                               | 20.10           | 6.00        | 3,323.1             | 607.4      | 52.8       | 608.0                 | 2.89                  | 0.32                 | 8.42                |
| 3,500.0                               | 21.50           | 10.90       | 3,411.9             | 640.8      | 57.8       | 641.7                 | 2.35                  | 1.47                 | 5.16                |
| 3,595.0                               | 21.10           | 13.80       | 3,500.4             | 674.5      | 65.2       | 676.1                 | 1.19                  | -0.42                | 3.05                |
| 3,690.0                               | 20.40           | 13.10       | 3,589.2             | 707.2      | 73.0       | 709.7                 | 0.78                  | -0.74                | -0.74               |
| 3,785.0                               | 20.50           | 14.90       | 3,678.2             | 739.4      | 81.1       | 742.8                 | 0.67                  | 0.11                 | 1.89                |
| 3,881.0                               | 20.50           | 15.60       | 3,768.2             | 771.8      | 89.9       | 776.2                 | 0.26                  | 0.00                 | 0.73                |
| 3,976.0                               | 18.20           | 13.50       | 3,857.8             | 802.3      | 97.8       | 807.5                 | 2.53                  | -2.42                | -2.21               |
| 4,071.0                               | 18.80           | 10.70       | 3,947.9             | 831.8      | 104.2      | 837.6                 | 1.13                  | 0.63                 | -2.95               |
| 4,166.0                               | 20.00           | 13.60       | 4,037.5             | 862.6      | 110.8      | 869.1                 | 1.62                  | 1.26                 | 3.05                |
| 4,261.0                               | 20.90           | 16.70       | 4,126.5             | 894.6      | 119.5      | 902.2                 | 1.48                  | 0.95                 | 3.26                |
| 4,356.0                               | 20.70           | 16.90       | 4,215.3             | 926.9      | 129.3      | 935.6                 | 0.22                  | -0.21                | 0.21                |
| 4,451.0                               | 21.00           | 16.70       | 4,304.1             | 959.3      | 139.0      | 969.1                 | 0.32                  | 0.32                 | -0.21               |
| 4,547.0                               | 20.30           | 13.80       | 4,393.9             | 991.9      | 147.9      | 1,002.8               | 1.29                  | -0.73                | -3.02               |
| 4,642.0                               | 19.50           | 23.10       | 4,483.3             | 1,022.5    | 158.1      | 1,034.6               | 3.43                  | -0.84                | 9.79                |
| 4,737.0                               | 20.40           | 22.00       | 4,572.6             | 1,052.5    | 170.5      | 1,066.2               | 1.03                  | 0.95                 | -1.16               |
| 4,832.0                               | 19.60           | 17.50       | 4,661.8             | 1,083.0    | 181.5      | 1,098.1               | 1.83                  | -0.84                | -4.74               |
| 4,927.0                               | 19.20           | 16.70       | 4,751.5             | 1,113.2    | 190.8      | 1,129.4               | 0.51                  | -0.42                | -0.84               |
| 5,022.0                               | 18.20           | 15.20       | 4,841.4             | 1,142.4    | 199.2      | 1,159.6               | 1.17                  | -1.05                | -1.58               |
| 5,117.0                               | 17.40           | 14.40       | 4,931.9             | 1,170.5    | 206.6      | 1,188.5               | 0.88                  | -0.84                | -0.84               |
| 5,128.0                               | 17.04           | 13.68       | 4,942.4             | 1,173.7    | 207.4      | 1,191.8               | 3.81                  | -3.27                | -6.60               |
| <b>4935' MD = 172' Radius</b>         |                 |             |                     |            |            |                       |                       |                      |                     |
| 5,212.0                               | 14.40           | 7.00        | 5,023.3             | 1,196.0    | 211.6      | 1,214.5               | 3.81                  | -3.14                | -7.95               |
| 5,307.0                               | 13.30           | 2.80        | 5,115.5             | 1,218.7    | 213.5      | 1,237.2               | 1.57                  | -1.16                | -4.42               |
| 5,402.0                               | 11.60           | 0.30        | 5,208.3             | 1,239.1    | 214.1      | 1,257.4               | 1.88                  | -1.79                | -2.63               |
| 5,498.0                               | 10.20           | 358.60      | 5,302.5             | 1,257.3    | 214.0      | 1,275.3               | 1.50                  | -1.46                | -1.77               |
| 5,593.0                               | 8.20            | 341.80      | 5,396.3             | 1,272.1    | 211.7      | 1,289.6               | 3.50                  | -2.11                | -17.68              |
| 5,688.0                               | 7.20            | 337.20      | 5,490.5             | 1,284.0    | 207.2      | 1,300.7               | 1.24                  | -1.05                | -4.84               |
| 5,783.0                               | 5.20            | 339.70      | 5,584.9             | 1,293.6    | 203.4      | 1,309.4               | 2.12                  | -2.11                | 2.63                |
| 5,878.0                               | 3.40            | 323.00      | 5,679.6             | 1,299.9    | 200.2      | 1,315.1               | 2.29                  | -1.89                | -17.58              |
| 5,973.0                               | 1.90            | 324.60      | 5,774.5             | 1,303.4    | 197.6      | 1,318.2               | 1.58                  | -1.58                | 1.68                |
| 6,069.0                               | 0.60            | 325.60      | 5,870.5             | 1,305.1    | 196.4      | 1,319.7               | 1.35                  | -1.35                | 1.04                |
| 6,164.0                               | 0.40            | 354.50      | 5,965.5             | 1,305.8    | 196.1      | 1,320.4               | 0.33                  | -0.21                | 30.42               |
| 6,259.0                               | 0.60            | 40.40       | 6,060.5             | 1,306.6    | 196.4      | 1,321.1               | 0.45                  | 0.21                 | 48.32               |
| 6,298.5                               | 0.63            | 50.77       | 6,100.0             | 1,306.9    | 196.7      | 1,321.5               | 0.29                  | 0.07                 | 26.26               |
| <b>TARGET BHL 2090' FSL, 515' FEL</b> |                 |             |                     |            |            |                       |                       |                      |                     |
| 6,354.0                               | 0.70            | 63.30       | 6,155.5             | 1,307.2    | 197.2      | 1,321.9               | 0.29                  | 0.13                 | 22.57               |

|                  |                                      |                                     |                                      |
|------------------|--------------------------------------|-------------------------------------|--------------------------------------|
| <b>Company:</b>  | Anadarko, Weld County CO             | <b>Local Co-ordinate Reference:</b> | Well Cottonwood 9-33                 |
| <b>Project:</b>  | SEC.33-T2N-R66W                      | <b>TVD Reference:</b>               | WELL @ 5002.0ft (Original Well Elev) |
| <b>Site:</b>     | Cottonwood 16-33 Pad Sec.33-T2N-R66W | <b>MD Reference:</b>                | WELL @ 5002.0ft (Original Well Elev) |
| <b>Well:</b>     | Cottonwood 9-33                      | <b>North Reference:</b>             | True                                 |
| <b>Wellbore:</b> | Wellbore #1                          | <b>Survey Calculation Method:</b>   | Minimum Curvature                    |
| <b>Design:</b>   | Wellbore #1                          | <b>Database:</b>                    | Landmark                             |

Survey

| Measured Depth (ft)                                 | Inclination (°) | Azimuth (°) | Vertical Depth (ft) | +N/-S (ft) | +E/-W (ft) | Vertical Section (ft) | Dogleg Rate (°/100ft) | Build Rate (°/100ft) | Turn Rate (°/100ft) |
|---|-----------------|-------------|---------------------|------------|------------|-----------------------|-----------------------|----------------------|---------------------|
| 6,449.0   | 0.60            | 27.40       | 6,250.5             | 1,307.9    | 198.0      | 1,322.7               | 0.43                  | -0.11                | -37.79              |
| 6,544.0   | 0.60            | 19.00       | 6,345.5             | 1,308.8    | 198.4      | 1,323.7               | 0.09                  | 0.00                 | -8.84               |
| 6,640.0   | 1.00            | 67.10       | 6,441.5             | 1,309.6    | 199.3      | 1,324.6               | 0.78                  | 0.42                 | 50.10               |
| 6,735.0   | 1.00            | 48.40       | 6,536.5             | 1,310.5    | 200.7      | 1,325.7               | 0.34                  | 0.00                 | -19.68              |
| 6,830.0   | 0.70            | 15.20       | 6,631.4             | 1,311.6    | 201.5      | 1,326.9               | 0.59                  | -0.32                | -34.95              |
| 6,925.0   | 0.40            | 38.50       | 6,726.4             | 1,312.4    | 201.8      | 1,327.8               | 0.39                  | -0.32                | 24.53               |
| 7,020.0   | 0.50            | 75.30       | 6,821.4             | 1,312.8    | 202.4      | 1,328.2               | 0.32                  | 0.11                 | 38.74               |
| 7,115.0   | 0.40            | 113.50      | 6,916.4             | 1,312.8    | 203.1      | 1,328.3               | 0.33                  | -0.11                | 40.21               |
| 7,211.0   | 0.60            | 157.20      | 7,012.4             | 1,312.2    | 203.6      | 1,327.8               | 0.43                  | 0.21                 | 45.52               |
| 7,306.0   | 0.70            | 134.10      | 7,107.4             | 1,311.3    | 204.3      | 1,327.1               | 0.29                  | 0.11                 | -24.32              |
| 7,362.8   | 0.64            | 129.28      | 7,164.2             | 1,310.9    | 204.7      | 1,326.7               | 0.15                  | -0.11                | -8.49               |
| <b>TARGET CIRCLE 2090'FSL, 515'FEL</b>              |                 |             |                     |            |            |                       |                       |                      |                     |
| 7,401.0   | 0.60            | 125.50      | 7,202.4             | 1,310.6    | 205.1      | 1,326.5               | 0.15                  | -0.10                | -9.89               |
| 7,496.0   | 0.40            | 112.70      | 7,297.4             | 1,310.2    | 205.8      | 1,326.2               | 0.24                  | -0.21                | -13.47              |
| 7,591.0   | 0.40            | 84.80       | 7,392.4             | 1,310.1    | 206.4      | 1,326.2               | 0.20                  | 0.00                 | -29.37              |
| 7,686.0   | 0.90            | 74.80       | 7,487.4             | 1,310.3    | 207.5      | 1,326.6               | 0.54                  | 0.53                 | -10.53              |
| 7,782.0   | 0.90            | 65.80       | 7,583.4             | 1,310.8    | 208.9      | 1,327.3               | 0.15                  | 0.00                 | -9.38               |
| 7,877.0   | 0.70            | 67.50       | 7,678.4             | 1,311.3    | 210.1      | 1,328.1               | 0.21                  | -0.21                | 1.79                |
| 7,973.0   | 0.90            | 53.90       | 7,774.4             | 1,312.0    | 211.3      | 1,328.9               | 0.29                  | 0.21                 | -14.17              |
| 8,067.0   | 1.00            | 57.30       | 7,868.4             | 1,312.9    | 212.5      | 1,330.0               | 0.12                  | 0.11                 | 3.62                |
| 8,163.0   | 1.10            | 51.30       | 7,964.3             | 1,313.9    | 214.0      | 1,331.2               | 0.15                  | 0.10                 | -6.25               |
| 8,258.0   | 1.00            | 56.60       | 8,059.3             | 1,314.9    | 215.4      | 1,332.5               | 0.15                  | -0.11                | 5.58                |
| 8,267.0   | 1.00            | 46.60       | 8,068.3             | 1,315.0    | 215.5      | 1,332.6               | 1.94                  | 0.00                 | -111.11             |
| <b>LEGAL BOX 400' X 400' 1987'FSL &amp; 660'FEL</b> |                 |             |                     |            |            |                       |                       |                      |                     |
| 8,314.0   | 1.00            | 46.60       | 8,115.3             | 1,315.6    | 216.1      | 1,333.2               | 0.00                  | 0.00                 | 0.00                |

|                   |                    |             |
|-------------------|--------------------|-------------|
| Checked By: _____ | Approved By: _____ | Date: _____ |
|-------------------|--------------------|-------------|