



PLS Group, LLC  
 109 Coronado Ct. - Bldg. 7  
 Fort Collins, Colorado 80525

# WELL LOCATION CERTIFICATE

THIS MAP DOES NOT  
 REPRESENT A BOUNDARY SURVEY

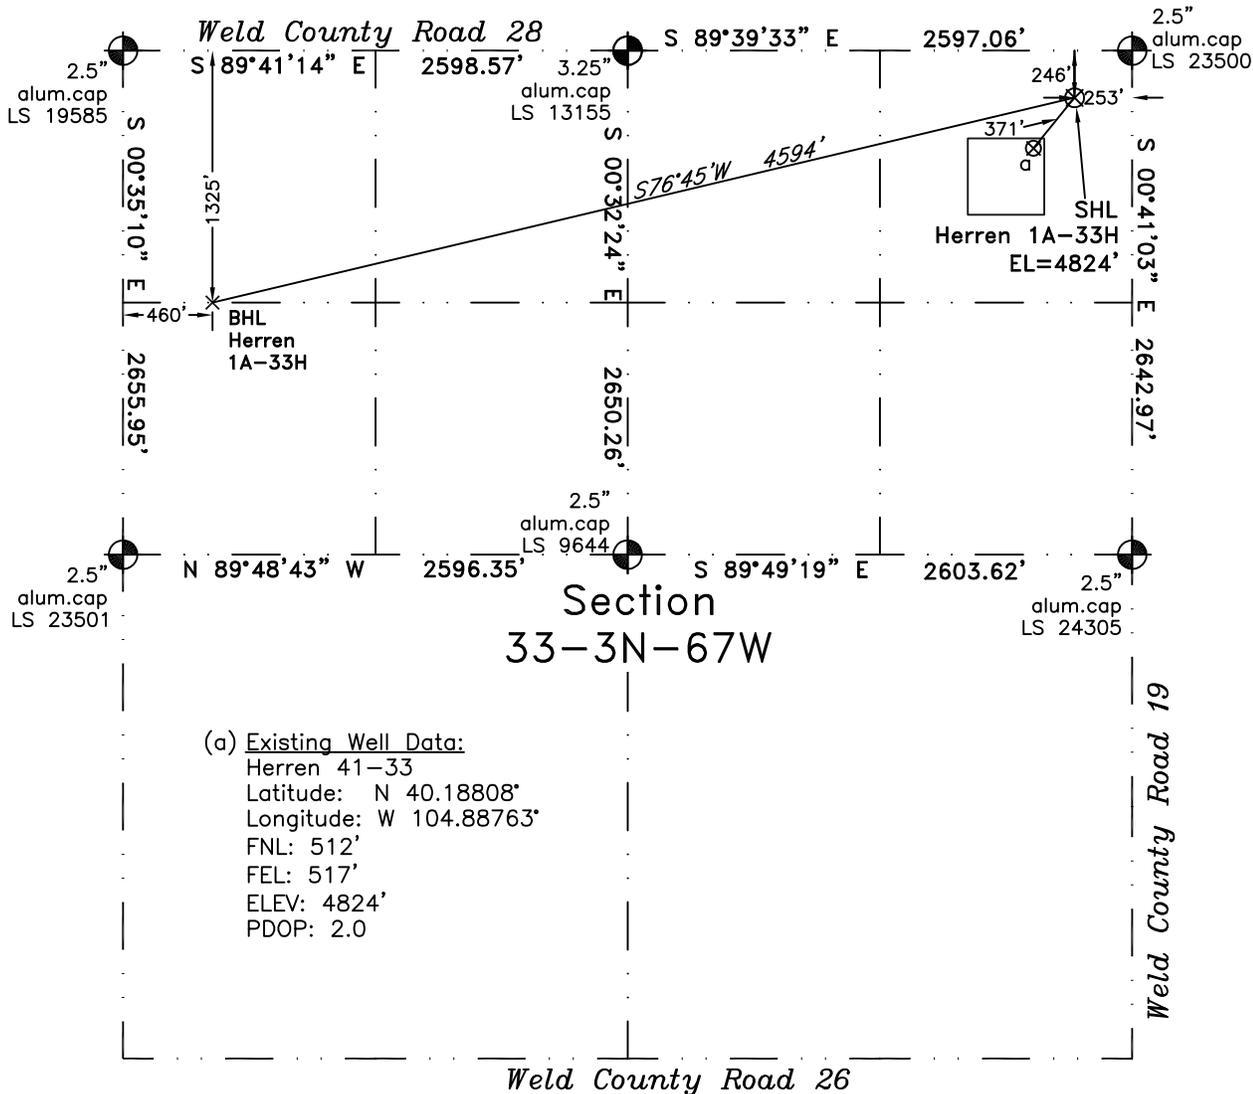

(a) Existing Well Data:  
 Herren 41-33  
 Latitude: N 40.18808°  
 Longitude: W 104.88763°  
 FNL: 512'  
 FEL: 517'  
 ELEV: 4824'  
 PDOP: 2.0

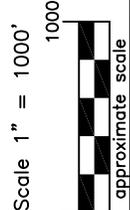

LEGEND  
 — found survey monument  
 (c) — calculated dimension

In accordance with a request from Dan Nelson of EnCana Oil & Gas (USA) Inc., PLS Group, LLC has determined the location of the Herren 1A-33H well site to be SHL: 246' FNL and 253' FEL, (Begin BHL 1325' FNL and 460' FWL) as measured at ninety (90) degrees from the section lines of Section 33, Township 3 North, Range 67 West, 6th Principal Meridian, County of Weld, CO.

Proposed Surface Hole Data:

Latitude: N 40.18880° BHL(40.18599°)  
 Longitude: W 104.88669° BHL(104.90272°)  
 PDOP: 0.9

Nearest: Building 402' southeast      Above Ground Utility 229' east  
 Public Road 241' east      Railroad 18,850' east  
 Property Line 246' north      Well Window: SHL is 286' outside  
 Existing Well: Herren 41-33 371' southwest

Notes:

- 1) Bearings and distances based on NAD 83 Colorado North State Plane Coordinates using RTK GPS observations taken 2/17/11 by operator Alex Perkins.
- 2) Conversion factor to ground (1.000271871).
- 3) Elevations based on NAVD 88 GPS heights and Geoid 2003 corrections.
- 4) See improvement map for visible improvements within 400 feet.
- 5) The surface use is agricultural field.

I hereby certify that this Well Location Certificate was prepared by me or under my direct supervision on 2/23/11 for and on behalf of EnCana Oil & Gas (USA) Inc. That it is not a Land Survey Plat or an Improvement Survey Plat and that it is not to be relied upon for establishment of fences, buildings, or other future improvement lines.

John Robert McGehee LS#38219  
 Well: Herren 1A-33H WLC

**NOTICE:** According to Colorado law you must commence any legal action based upon any defect in this W.L.C. within three years after you first discover such defect. In no event may any action based upon any defect in this W.L.C. be commenced more than ten years from this said date of the certification shown hereon.