

WELL LOCATION CERTIFICATE

SECTION 7, TOWNSHIP 5 NORTH, RANGE 67 WEST, 6TH P.M.

NOTES:

THIS IS A DIRECTIONAL DRILL WELL.
 BOTTOM HOLE AT 75' FSL, 1246' FWL.
 A PROPOSED WELL IS 22' N.
 AN EXISTING WELL IS 50' S.
 WELL FALLS IN A PLOWED FIELD.
 SEE LOCATION DRAWING FOR IMPROVEMENTS

GROUND ELEVATION = 4960'
 LAT & LONG. = N 40.40981°
 W 104.94120°


W1/4 SEC. 7
 3.25° AC LS 12374

BASIS OF BEARINGS
 2630.7'
 S00°13'51"W

SW SEC. 7
 3.25° AC LS 12374

1246.1' 1286.6' 2573.1'
 S89°25'45"W

SE SEC. 7
 2.5° AC ILLEG.

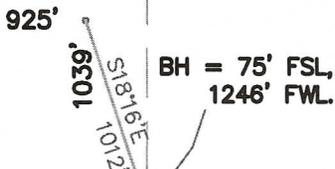

I HEREBY STATE TO UNIOIL THAT THIS WELL LOCATION CERTIFICATE FOR THE WELL ZEILER 7LDU IS LOCATED 1039' FSL & 925' FWL, SEC. 7, T5N, R67W, 6PM.

LEGEND

-  = FOUND MONUMENT
-  = PROPOSED WELL
-  = BOTTOM HOLE



SCALE 1" = 1000'

ELEVATION SOURCE = USGS 7.5' QUAD.MAP CONTOURS NGVD 1929 DATUM.

LAT. & LONG. ARE DIFFERENTIALLY CORRECTED (NAD'83) USING (DGPS) WITH (PDOP) VALUES LESS THAN SIX (6).

SHOWN DISTANCES ARE FIELD MEASURED - EXTERIOR SECTION LINES ARE DRAWN TO SCALE (BEST APPROX. OR FOUND MONUMENT ).

THOMAS G. CARLSON, PLS 24657
 HORSESHOE SURVEYING, LLC

THIS IS NOT A MONUMENTED BOUNDARY SURVEY, IT IS ONLY A DRAWING INTENDED TO DEPICT THE WELL LOCATION TO SECTION LINES.

DISTANCES TO WELL SHOWN PERPENDICULAR TO SECTION LINES.

PREPARED BY:	HORSESHOE SURVEYING, LLC PO BOX 150458 LAKEWOOD, CO 80215 (720)872-0196	WELL NAME:	ZEILER 7LDU	
DRAWING DATE: 12-22-10		LOCATION:	WELD COUNTY, CO SW1/4, SEC. 7, T5N, R67W, 6TH P.M.	
FIELD DATE: 12-21-10	BY: TGC	CHKD:	JOB NO.	SHEET NO. 1 OF 1

