




Lease Name: Ole 11-24 Legals: NWNW – Sec. 24, T6N, R65W

County: Weld County, Colorado API#: 05-123-23640

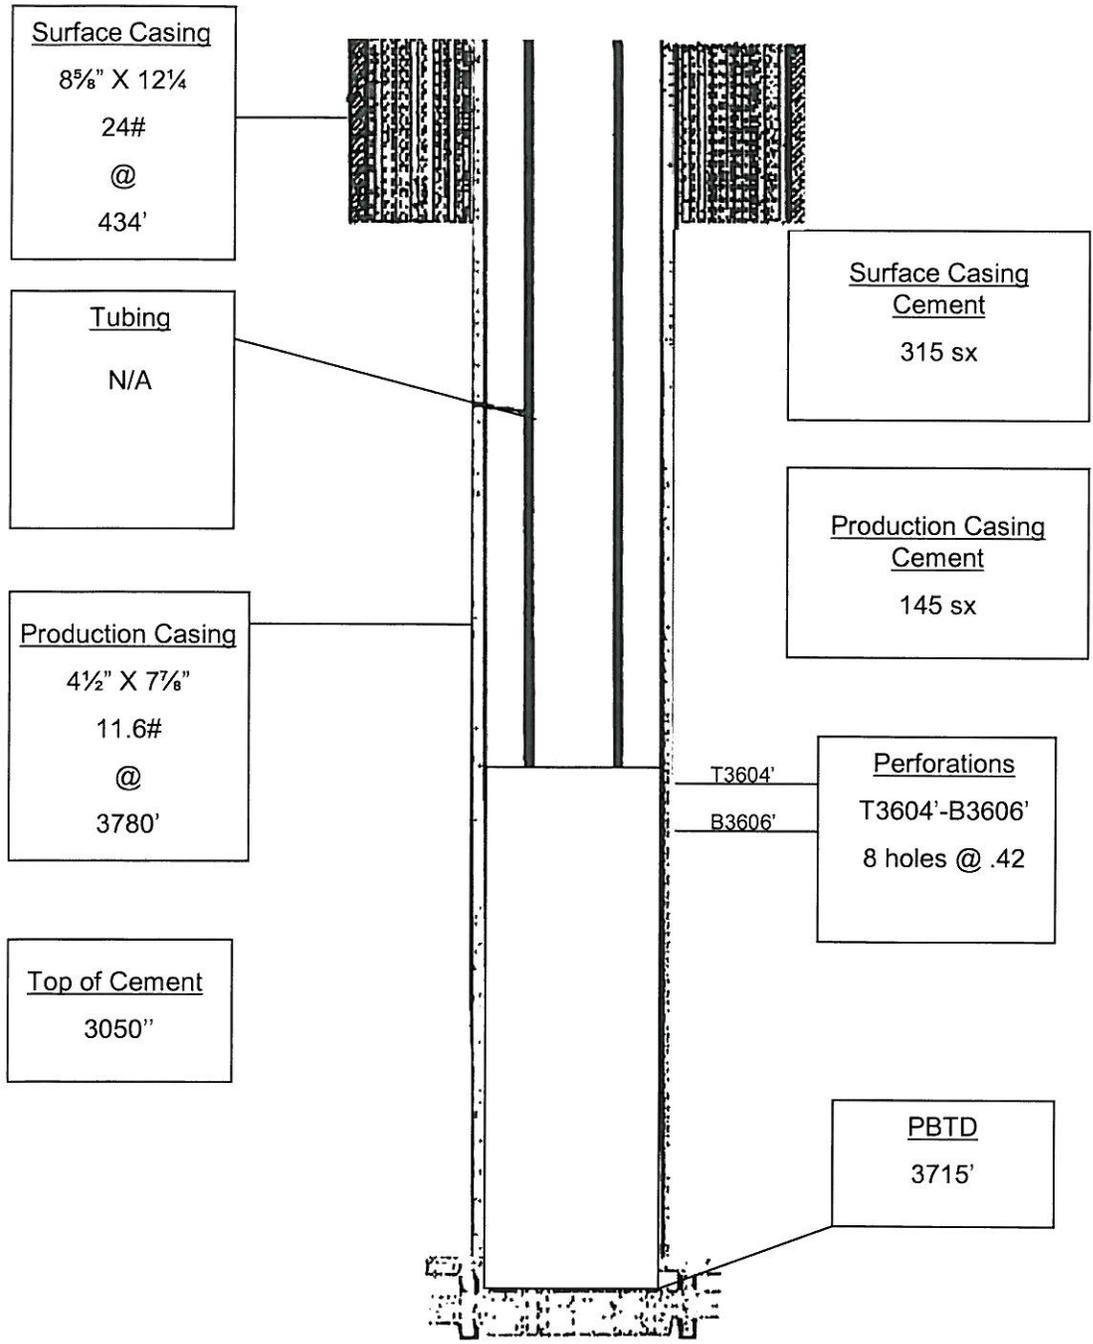

Wellbore Diagram