



# Shasta 24-8 (*Rancho Escondido Subdivision*)

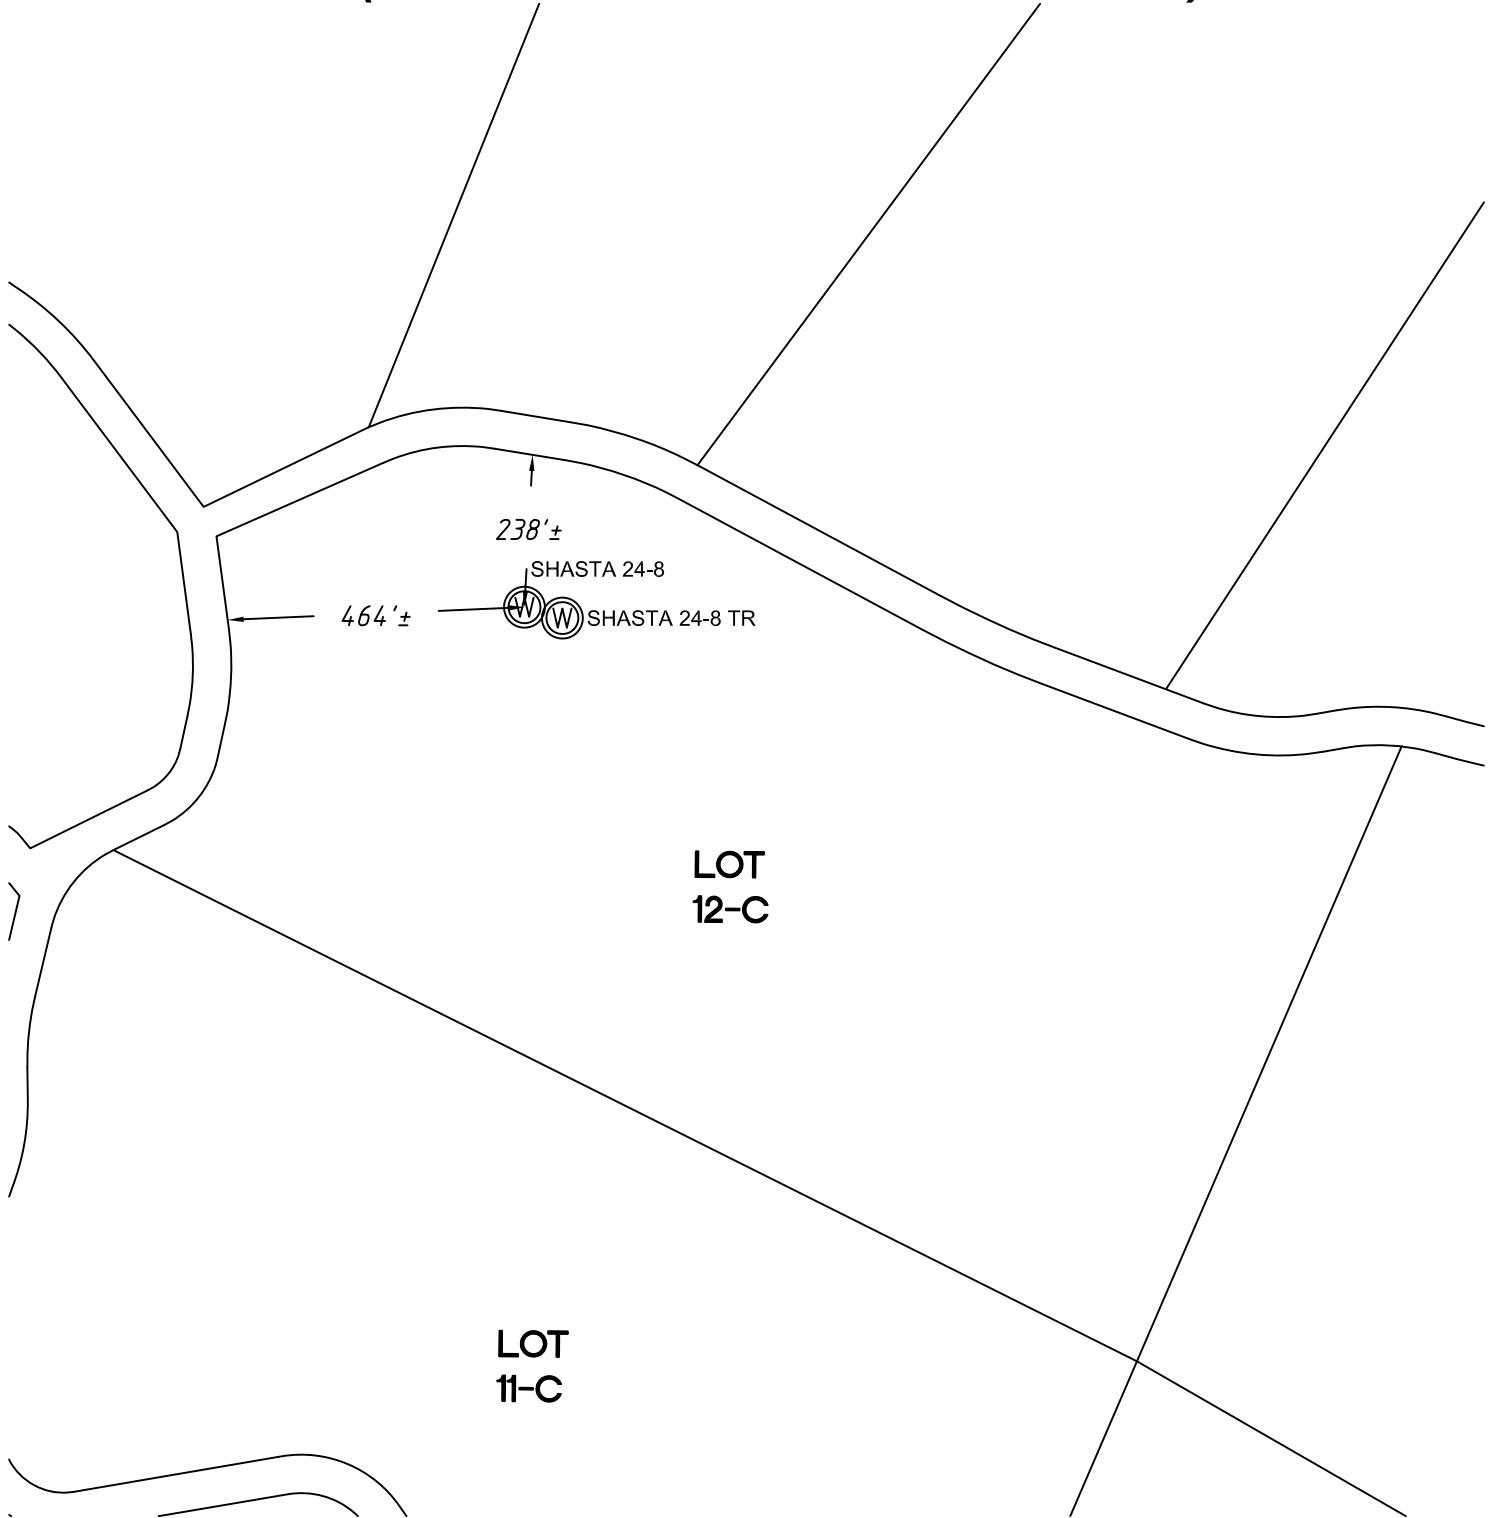

**NOTE:**  
FOOTAGES GIVEN ARE ONLY ESTIMATES BASED ON  
SUBDIVISION PLATS AND TIED TO EXISTING CONTROL.  
A FULL BOUNDARY SURVEY IS REQUIRED TO DETERMINE  
TRUE SUBDIVISION LOT AND ROAD LOCATIONS,  
DISTANCES AND AREA OR FOOTAGE CALCULATIONS.

DATE: November 09, 2010

## GRAPHIC SCALE

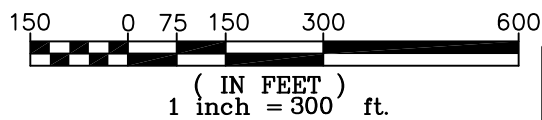

**SHIELDS SURVEY L<sup>td.</sup> C<sup>o.</sup>**  
Raton, New Mexico 87740  
(575)445-1232