

Noble Energy

Garfield County, CO (NAD 83)
Sec. 8-T8S-R95W (SGV 8D PAD)
SGV Federal 7-41C - B 2

Plan #2

Design: Vaughn Gyro and Sperry MWD Survey

Sperry Drilling Services

Final Survey Report

04 March, 2011

Well Coordinates: 1,573,825.52 N, 2,286,000.52 E (39° 22' 53.94" N, 108° 01' 34.81" W)
Ground Level: 6,341.70 ft

Local Coordinate Origin:	Centered on Well SGV Federal 7-41C - Slot B 2
Viewing Datum:	RKB 24' @ 6365.70ft (H&P 322)
TVDs to System:	N
North Reference:	Grid
Unit System:	API - US Survey Feet - Custom

Geodetic Scale Factor Applied
Version: 2003.16 Build: 43I

HALLIBURTON

Design Report for SGV Federal 7-41C - Vaughn Gyro and Sperry MWD Survey

Measured Depth (ft)	Inclination (°)	Azimuth (°)	Vertical Depth (ft)	+N/-S (ft)	+E/-W (ft)	Vertical Section (ft)	Dogleg Rate (°/100ft)
0.00	0.00	0.00	0.00	0.00	0.00	0.00	0.00
149.00	1.77	268.74	148.98	-0.05	-2.30	2.09	1.19
Surveys from 149.00ft to 365.00ft are Vaughn Gyro Surveys							
211.00	2.97	224.47	210.93	-1.22	-4.38	3.55	3.39
274.00	4.47	214.77	273.79	-4.40	-6.93	4.63	2.57
335.00	5.31	209.95	334.57	-8.80	-9.69	5.44	1.53
365.00	5.94	206.03	364.43	-11.40	-11.07	5.68	2.46
Tie-On to Vaughn Gyro Survey							
442.00	8.19	229.65	440.85	-18.53	-17.00	8.32	4.71
First Sperry MWD Survey							
524.00	9.03	239.64	521.93	-25.56	-27.00	14.74	2.09
615.00	10.38	249.78	611.63	-32.01	-40.86	24.94	2.39
707.00	11.34	256.82	701.99	-36.93	-57.44	38.24	1.78
799.00	12.57	270.50	792.01	-38.91	-76.26	54.76	3.35
893.00	10.74	289.11	884.10	-35.95	-94.78	72.94	4.42
987.00	10.86	302.98	976.45	-28.26	-110.48	90.41	2.76
1,082.00	10.27	306.43	1,069.84	-18.36	-124.81	107.47	0.91
1,176.00	12.21	305.29	1,162.03	-7.64	-139.66	125.35	2.08
1,271.00	14.62	307.33	1,254.44	5.43	-157.40	146.80	2.58
1,365.00	14.47	308.01	1,345.42	19.86	-176.08	169.66	0.24
1,459.00	15.28	305.48	1,436.27	34.28	-195.42	193.12	1.10
1,556.00	15.56	304.50	1,529.78	49.07	-216.55	218.37	0.39
1,650.00	17.09	302.89	1,619.99	63.71	-238.54	244.35	1.70
1,744.00	16.79	301.20	1,709.91	78.24	-261.76	271.41	0.61
1,839.00	17.59	300.32	1,800.67	92.60	-285.88	299.24	0.89
1,933.00	15.90	301.44	1,890.68	106.49	-309.13	326.08	1.83
2,028.00	16.94	299.06	1,981.80	120.00	-332.33	352.73	1.30
2,122.00	16.67	296.52	2,071.79	132.67	-356.37	379.81	0.83
2,216.00	17.66	294.55	2,161.60	144.61	-381.40	407.53	1.22
2,311.00	16.82	294.70	2,252.33	156.34	-407.00	435.67	0.89
2,405.00	18.40	295.21	2,341.93	168.35	-432.78	464.10	1.69
2,499.00	17.02	293.07	2,431.47	180.06	-458.86	492.68	1.62
2,594.00	15.10	296.01	2,522.76	190.93	-482.77	518.95	2.19
2,688.00	15.11	297.08	2,613.51	201.88	-504.69	543.40	0.30
2,783.00	16.05	300.36	2,705.02	214.16	-527.04	568.79	1.36
2,877.00	16.85	298.74	2,795.18	227.27	-550.20	595.24	0.98
2,971.00	16.99	302.46	2,885.11	241.20	-573.73	622.36	1.16
3,065.00	16.45	301.74	2,975.13	255.57	-596.64	649.07	0.62
3,160.00	15.55	301.30	3,066.45	269.26	-618.96	674.98	0.96
3,254.00	16.98	304.45	3,156.69	283.57	-641.05	700.92	1.79
3,348.00	15.90	304.46	3,246.85	298.62	-662.98	727.01	1.15
3,443.00	18.41	307.37	3,337.61	315.09	-685.64	754.33	2.79
3,537.00	17.54	307.42	3,427.03	332.71	-708.69	782.45	0.93
3,631.00	16.30	304.66	3,516.96	348.82	-730.79	809.11	1.57
3,725.00	16.63	302.32	3,607.10	363.51	-753.00	835.32	0.79
3,820.00	15.54	300.53	3,698.38	377.25	-775.46	861.37	1.26
3,914.00	15.93	303.26	3,788.86	390.72	-797.09	886.56	0.89
4,008.00	16.35	300.21	3,879.16	404.45	-819.31	912.39	1.01
4,102.00	14.98	300.53	3,969.66	417.28	-841.21	937.58	1.46
4,197.00	13.34	297.34	4,061.78	428.55	-861.52	960.69	1.91

Design Report for SGV Federal 7-41C - Vaughn Gyro and Sperry MWD Survey

Measured Depth (ft)	Inclination (°)	Azimuth (°)	Vertical Depth (ft)	+N/-S (ft)	+E/-W (ft)	Vertical Section (ft)	Dogleg Rate (°/100ft)
4,291.00	11.99	298.01	4,153.49	438.12	-879.78	981.23	1.44
4,385.00	10.83	296.48	4,245.63	446.64	-896.30	999.78	1.28
4,480.00	9.99	299.09	4,339.06	454.63	-911.49	1,016.89	1.01
4,574.00	8.93	294.08	4,431.78	461.57	-925.28	1,032.29	1.43
4,668.00	6.18	294.72	4,524.96	466.66	-936.54	1,044.65	2.93
4,762.00	5.71	298.49	4,618.45	471.01	-945.24	1,054.36	0.65
4,856.00	4.00	281.98	4,712.12	473.92	-952.56	1,062.24	2.33
4,951.00	3.46	250.84	4,806.93	473.67	-958.51	1,067.60	2.18
5,045.00	2.42	237.60	4,900.80	471.67	-962.86	1,070.82	1.31
5,139.00	2.10	237.82	4,994.73	469.69	-966.00	1,072.92	0.34
5,234.00	3.43	243.33	5,089.62	467.49	-970.01	1,075.74	1.43
5,328.00	2.37	242.50	5,183.49	465.33	-974.25	1,078.78	1.13
5,422.00	2.72	238.48	5,277.40	463.27	-977.87	1,081.30	0.42
5,517.00	2.36	228.97	5,372.31	460.80	-981.27	1,083.45	0.58
5,611.00	2.51	229.96	5,466.22	458.21	-984.31	1,085.22	0.17
5,705.00	2.16	220.10	5,560.15	455.53	-987.02	1,086.66	0.57
5,800.00	2.29	207.37	5,655.08	452.47	-989.05	1,087.32	0.54
5,894.00	2.34	215.18	5,749.00	449.24	-991.02	1,087.86	0.34
5,988.00	2.04	239.16	5,842.93	446.81	-993.56	1,089.24	1.02
6,083.00	1.93	225.37	5,937.88	444.82	-996.15	1,090.83	0.51
6,177.00	2.79	224.14	6,031.79	442.07	-998.87	1,092.25	0.92
6,271.00	3.75	220.23	6,125.64	438.08	-1,002.45	1,093.96	1.05
6,365.00	3.72	226.66	6,219.44	433.64	-1,006.65	1,096.08	0.45
6,459.00	3.31	224.48	6,313.26	429.61	-1,010.77	1,098.28	0.46
6,554.00	3.41	222.59	6,408.10	425.57	-1,014.60	1,100.21	0.16
6,648.00	3.04	235.36	6,501.95	422.10	-1,018.55	1,102.46	0.86
6,742.00	3.37	251.46	6,595.81	419.80	-1,023.22	1,105.85	1.02
6,810.00	3.56	251.60	6,663.68	418.50	-1,027.12	1,108.92	0.28
Final Sperry MWD Survey							
6,870.00	3.56	251.60	6,723.57	417.33	-1,030.65	1,111.71	0.00
Survey Projection to TD - Estimated BHL: 853' FNL, 745' FEL							

Design Annotations

Measured Depth (ft)	Vertical Depth (ft)	Local Coordinates		Comment
		+N/-S (ft)	+E/-W (ft)	
149.00	148.98	-0.05	-2.30	Surveys from 149.00ft to 365.00ft are Vaughn Gyro Surveys
365.00	364.43	-11.40	-11.07	Tie-On to Vaughn Gyro Survey
442.00	440.85	-18.53	-17.00	First Sperry MWD Survey
6,810.00	6,663.68	418.50	-1,027.12	Final Sperry MWD Survey
6,870.00	6,723.57	417.33	-1,030.65	Survey Projection to TD
6,870.00	6,723.57	417.33	-1,030.65	Estimated BHL: 853' FNL, 745' FEL

Vertical Section Information

Angle Type	Target	Azimuth (°)	Origin Type	Origin		Start TVD (ft)
				+N/-S (ft)	+E/-W (ft)	
Target	SGV Federal 7-41C Plan #2 BH Tgt	293.21	Slot	0.00	0.00	0.00

Design Report for SGV Federal 7-41C - Vaughn Gyro and Sperry MWD Survey

Survey tool program

From (ft)	To (ft)	Survey/Plan	Survey Tool
149.00	365.00	Vaughn Gyro Surveys	NS-GYRO-MS
442.00	6,870.00	Sperry MWD Surveys	MWD

Targets

Target Name - hit/miss target - Shape	Dip Angle (°)	Dip Dir. (°)	TVD (ft)	+N/-S (ft)	+E/-W (ft)	Northing (ft)	Easting (ft)	Latitude	Longitude
SGV Federal 7-41C - actual wellpath misses target center by 898.72ft at 6870.00ft MD (6723.57 TVD, 417.33 N, -1030.65 E) - Point	0.00	0.00	7,622.00	438.36	-1,022.42	1,574,263.85	2,284,978.15	39° 22' 57.994 N	108° 1' 47.982 W
SGV Federal 7-41C - actual wellpath misses target center by 7.96ft at 5166.66ft MD (5022.36 TVD, 469.12 N, -966.95 E) - Rectangle (sides W25.00 H25.00 D0.00)	0.00	0.00	5,022.00	463.36	-972.42	1,574,288.86	2,285,028.15	39° 22' 58.254 N	108° 1' 47.354 W
SGV Federal 7-41C - actual wellpath misses target center by 63.39ft at 5169.35ft MD (5025.05 TVD, 469.06 N, -967.05 E) - Rectangle (sides W100.00 H200.00 D2,600.00)	0.00	0.00	5,022.00	438.36	-1,022.42	1,574,263.85	2,284,978.15	39° 22' 57.994 N	108° 1' 47.982 W

North Reference Sheet for Sec. 8-T8S-R95W (SGV 8D PAD) - SGV Federal 7-41C - Plan #2

All data is in US Feet unless otherwise stated. Directions and Coordinates are relative to Grid North Reference.

Vertical Depths are relative to RKB 24' @ 6365.70ft (H&P 322). Northing and Easting are relative to SGV Federal 7-41C - Slot B 2

Coordinate System is US State Plane 1983, Colorado Central Zone using datum North American Datum 1983, ellipsoid GRS 1980

Projection method is Lambert Conformal Conic (2 parallel)

Central Meridian is 105° 30' 0.000 W°, Longitude Origin:0° 0' 0.000 E°, Latitude Origin:39° 45' 0.000 N°

False Easting: 3,000,000.00ft, False Northing: 1,000,000.00ft, Scale Reduction: 0.99994787


Grid Coordinates of Well: 1,573,825.52 ft N, 2,286,000.52 ft E

Geographical Coordinates of Well: 39° 22' 53.94" N, 108° 01' 34.81" W

Grid Convergence at Surface is: -1.59°

Based upon Minimum Curvature type calculations, at a Measured Depth of 6,870.00ft
the Bottom Hole Displacement is 1,111.94ft in the Direction of 292.04° (Grid).

Magnetic Convergence at surface is: -12.04° (30 September 2010, , BGGM2010)

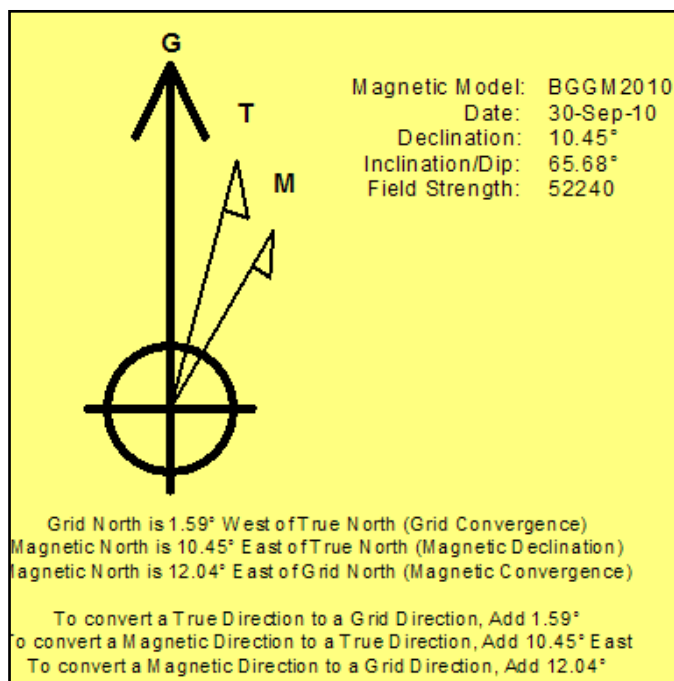

Project: Garfield County, CO (NAD 83)
 Site: Sec. 8-T8S-R95W (SGV 8D PAD)
 Well: SGV Federal 7-41C

Noble Energy

HALLIBURTON

Sperry Drilling



Azimuths to Grid North
 True North: 1.59°
 Magnetic North: 12.04°


Magnetic Field
 Strength: 52240.2snT
 Dip Angle: 65.68°
 Date: 9/30/2010
 Model: BGGM2010

LEGEND

- SGV Federal 7-41C, Plan #2, Plan #2 Proposal V0
- Vaughn Gyro and Sperry MWD Survey

Halliburton Energy Services, Inc. ("Halliburton") recently completed directional drilling and MWD operations at the SGV Federal 7-41C well located at Garfield County, CO. At the conclusion of the job Halliburton performed a final survey on the well. Noble Energy has requested that Halliburton provide them the distances from BHL to section lines from that final survey to allow Noble Energy to meet its requirements under Colorado law. These distances are generated by a mathematical algorithm based on rough data collected after the well is drilled. Halliburton considers it to be a rough estimate only and it is not to be relied upon in any application where accurate data is required. In consideration for Halliburton releasing this data to Noble Energy, Noble Energy agrees to release Halliburton from any consequences of it or anyone else relying on such data.


Permitted BHL: 832' FNL, 737' FEL

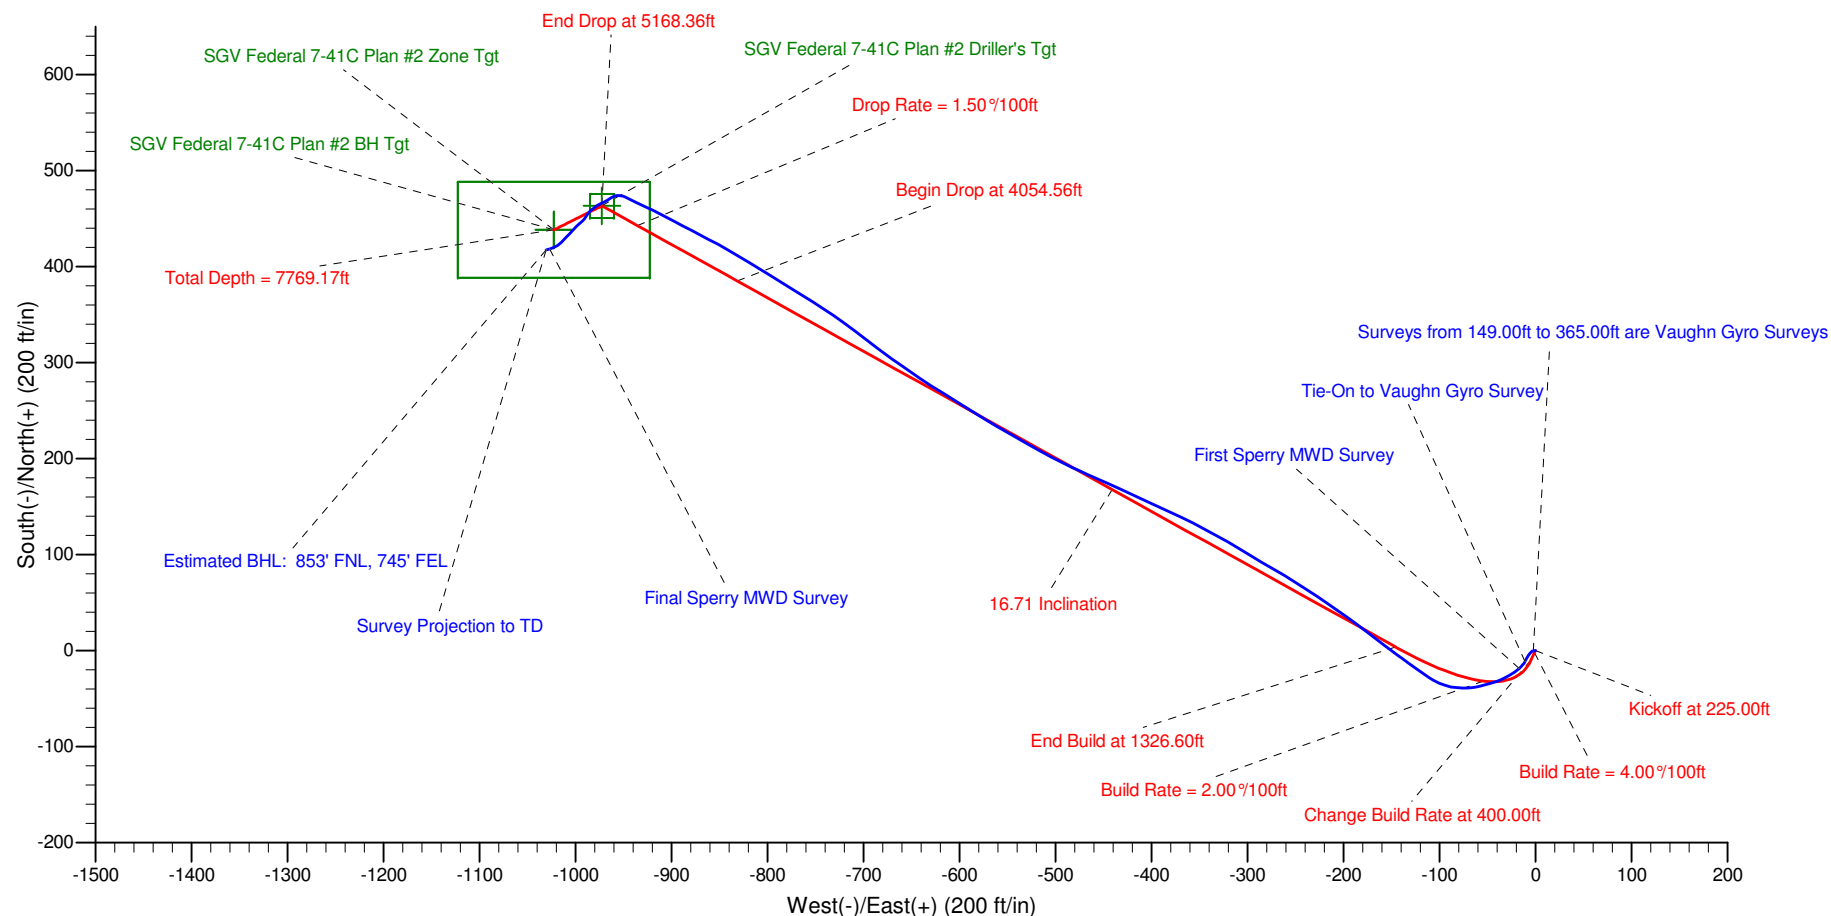

Noble Energy

HALLIBURTON

Sperry Drilling

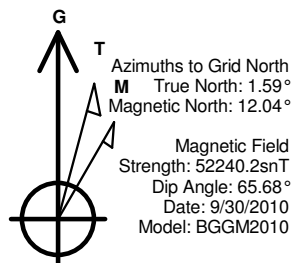

LEGEND

- SGV Federal 7-41C, Plan #2, Plan #2 Proposal V0
- Vaughn Gyro and Sperry MWD Survey

Halliburton Energy Services, Inc. ("Halliburton") recently completed directional drilling and MWD operations at the SGV Federal 7-41C well located at Garfield County, CO. At the conclusion of the job Halliburton performed a final survey on the well. Noble Energy has requested that Halliburton provide them the distances from BHL to section lines from that final survey to allow Noble Energy to meet its requirements under Colorado law. These distances are generated by a mathematical algorithm based on rough data collected after the well is drilled. Halliburton considers it to be a rough estimate only and it is not to be relied upon in any application where accurate data is required. In consideration for Halliburton releasing this data to Noble Energy, Noble Energy agrees to release Halliburton from any consequences of it or anyone else relying on such data.

