

Noble Energy

Garfield County, CO (NAD 83)
Sec. 8-T8S-R95W (SGV 8D PAD)
SGV Federal 8-11C - A11

Plan #2

Design: Gyro and Sperry MWD Survey

Sperry Drilling Services

Final Survey Report

03 February, 2011

Well Coordinates: 1,573,858.02 N, 2,286,059.77 E (39° 22' 54.28" N, 108° 01' 34.07" W)
Ground Level: 6,341.70 ft

Local Coordinate Origin:	Centered on Well SGV Federal 8-11C - Slot A11
Viewing Datum:	RKB 24' @ 6365.70ft (H&P 322)
TVDs to System:	N
North Reference:	Grid
Unit System:	API - US Survey Feet - Custom

Geodetic Scale Factor Applied
Version: 2003.16 Build: 43I

HALLIBURTON

Design Report for SGV Federal 8-11C - Gyro and Sperry MWD Survey

Measured Depth (ft)	Inclination (°)	Azimuth (°)	Vertical Depth (ft)	+N/-S (ft)	+E/-W (ft)	Vertical Section (ft)	Dogleg Rate (°/100ft)
0.00	0.00	0.00	0.00	0.00	0.00	0.00	0.00
120.00	1.64	43.55	119.98	1.24	1.18	1.72	1.37
Surveys from 120.00ft to 367.00ft are Gyro Surveys							
151.00	1.96	36.44	150.97	1.99	1.80	2.69	1.26
182.00	1.89	45.10	181.95	2.78	2.48	3.73	0.96
213.00	2.01	50.44	212.93	3.49	3.26	4.77	0.70
275.00	1.47	60.67	274.90	4.57	4.79	6.61	1.00
367.00	2.70	58.18	366.84	6.29	7.66	9.82	1.34
Tie-On to Gyro Survey							
442.00	4.45	47.95	441.69	9.17	11.33	14.42	2.47
First Sperry MWD Survey							
525.00	5.33	46.38	524.39	13.99	16.51	21.47	1.07
616.00	5.73	46.97	614.97	20.00	22.89	30.22	0.44
708.00	6.93	45.49	706.40	27.03	30.20	40.34	1.32
800.00	8.26	43.17	797.60	35.74	38.68	52.49	1.48
894.00	6.99	47.57	890.76	44.52	47.53	64.94	1.49
988.00	7.05	47.12	984.06	52.31	55.97	76.39	0.09
1,083.00	7.75	50.63	1,078.27	60.34	65.20	88.54	0.88
1,177.00	6.99	44.22	1,171.49	68.46	74.09	100.54	1.19
1,272.00	6.58	45.53	1,265.83	76.41	82.00	111.75	0.46
1,366.00	6.79	46.81	1,359.19	83.99	89.90	122.67	0.27
1,461.00	6.67	41.87	1,453.53	91.94	97.67	133.79	0.62
1,490.00	7.13	44.17	1,482.32	94.49	100.05	137.27	1.85
1,645.00	6.48	37.09	1,636.23	108.36	112.03	155.60	0.68
1,739.00	6.53	38.93	1,729.63	116.75	118.59	166.21	0.23
1,833.00	7.98	48.66	1,822.88	125.22	126.85	178.03	2.02
1,928.00	7.95	45.85	1,916.96	134.15	136.51	191.15	0.41
2,022.00	8.98	42.59	2,009.94	144.08	146.14	204.98	1.21
2,116.00	9.55	40.92	2,102.71	155.37	156.21	220.11	0.67
2,211.00	8.54	40.21	2,196.53	166.72	165.93	235.03	1.07
2,305.00	9.06	47.91	2,289.42	177.01	175.93	249.38	1.37
2,400.00	10.03	45.37	2,383.11	187.83	187.37	265.09	1.11
2,494.00	9.97	44.75	2,475.68	199.36	198.92	281.39	0.13
2,588.00	9.26	43.14	2,568.36	210.66	209.82	297.09	0.81
2,683.00	7.93	44.35	2,662.29	220.93	219.63	311.28	1.41
2,777.00	9.03	46.34	2,755.26	230.66	229.50	325.13	1.21
2,871.00	8.94	46.56	2,848.11	240.77	240.14	339.77	0.10
2,966.00	9.17	47.01	2,941.92	251.01	251.03	354.68	0.25
3,060.00	8.79	44.17	3,034.77	261.27	261.52	369.33	0.62
3,154.00	8.39	45.46	3,127.72	271.23	271.41	383.36	0.47
3,248.00	7.69	45.62	3,220.79	280.44	280.79	396.49	0.75
3,343.00	9.19	40.76	3,314.76	290.63	290.29	410.42	1.75
3,437.00	8.41	40.40	3,407.65	301.55	299.65	424.79	0.83
3,531.00	8.50	42.54	3,500.63	311.90	308.80	438.61	0.35
3,626.00	8.18	41.54	3,594.63	322.14	318.03	452.39	0.37
3,720.00	7.95	39.85	3,687.70	332.13	326.63	465.57	0.35
3,814.00	7.06	37.12	3,780.89	341.73	334.28	477.81	1.02
3,909.00	7.68	42.37	3,875.11	351.07	342.08	489.97	0.96
4,003.00	7.65	46.10	3,968.27	360.05	350.82	502.50	0.53
4,097.00	7.03	40.81	4,061.50	368.74	359.09	514.49	0.98

Design Report for SGV Federal 8-11C - Gyro and Sperry MWD Survey

Measured Depth (ft)	Inclination (°)	Azimuth (°)	Vertical Depth (ft)	+N/-S (ft)	+E/-W (ft)	Vertical Section (ft)	Dogleg Rate (°/100ft)
4,191.00	6.51	47.01	4,154.85	376.73	366.75	525.55	0.95
4,286.00	6.44	48.06	4,249.24	383.97	374.65	536.23	0.14
4,380.00	6.52	57.03	4,342.64	390.39	383.05	546.64	1.08
4,474.00	5.37	53.31	4,436.13	395.93	391.05	556.13	1.29
4,568.00	5.06	57.62	4,529.75	400.77	398.08	564.46	0.53
4,663.00	4.16	62.73	4,624.44	404.60	404.68	571.74	1.04
4,757.00	3.49	69.91	4,718.23	407.14	410.40	577.48	0.87
4,851.00	3.17	73.04	4,812.07	408.88	415.57	582.27	0.39
4,945.00	0.86	159.37	4,906.02	408.98	418.31	584.19	3.44
5,040.00	1.62	169.05	5,000.99	406.99	418.81	583.07	0.83
5,134.00	1.86	242.86	5,094.96	404.99	417.71	580.85	2.23
5,228.00	1.42	246.21	5,188.92	403.83	415.29	578.35	0.48
5,323.00	1.74	257.71	5,283.89	403.05	412.80	576.09	0.47
5,417.00	2.26	253.60	5,377.83	402.22	409.63	573.34	0.57
5,511.00	2.16	255.88	5,471.76	401.26	406.13	570.27	0.14
5,605.00	2.28	239.66	5,565.69	399.89	402.80	567.00	0.68
5,700.00	2.46	252.20	5,660.61	398.31	399.23	563.42	0.58
5,794.00	2.06	239.43	5,754.54	396.83	395.85	560.05	0.68
5,888.00	2.03	265.82	5,848.48	395.85	392.74	557.22	0.99
5,983.00	1.39	273.69	5,943.44	395.80	389.91	555.27	0.72
6,077.00	1.64	245.54	6,037.40	395.32	387.55	553.31	0.83
6,171.00	3.31	239.29	6,131.31	393.38	383.99	549.48	1.80
6,266.00	3.58	231.17	6,226.14	390.12	379.32	543.92	0.59
6,360.00	3.59	238.08	6,319.96	386.72	374.54	538.18	0.46
6,454.00	2.58	254.39	6,413.82	384.60	370.00	533.54	1.41
6,548.00	2.73	259.36	6,507.72	383.61	365.76	529.95	0.29
6,642.00	1.93	263.56	6,601.64	383.02	361.99	526.96	0.87
6,705.00	2.46	263.23	6,664.60	382.74	359.59	525.14	0.84
Final Sperry MWD Survey							
6,765.00	2.46	263.23	6,724.54	382.44	357.03	523.18	0.00
Survey Projection to TD - Estimated BHL: 825' FNL, 701' FWL							

Design Annotations

Measured Depth (ft)	Vertical Depth (ft)	Local Coordinates		Comment
		+N/-S (ft)	+E/-W (ft)	
120.00	119.98	1.24	1.18	Surveys from 120.00ft to 367.00ft are Gyro Surveys
367.00	366.84	6.29	7.66	Tie-On to Gyro Survey
442.00	441.69	9.17	11.33	First Sperry MWD Survey
6,705.00	6,664.60	382.74	359.59	Final Sperry MWD Survey
6,765.00	6,724.54	382.44	357.03	Survey Projection to TD
6,765.00	6,724.54	382.44	357.03	Estimated BHL: 825' FNL, 701' FWL

Vertical Section Information

Angle Type	Target	Azimuth (°)	Origin Type	Origin		Start TVD (ft)
				+N/-S (ft)	+E/-W (ft)	
Target	SGV Federal 8-11C Plan #2 BH Tgt	42.60	Slot	0.00	0.00	0.00

Design Report for SGV Federal 8-11C - Gyro and Sperry MWD Survey

Survey tool program

From (ft)	To (ft)	Survey/Plan	Survey Tool
120.00	367.00	Gyro Survey	NS-GYRO-MS
442.00	6,765.00	Sperry MWD Surveys	MWD

Targets

Target Name - hit/miss target - Shape	Dip Angle (°)	Dip Dir. (°)	TVD (ft)	+N/-S (ft)	+E/-W (ft)	Northing (ft)	Easting (ft)	Latitude	Longitude
SGV Federal 8-11C - actual wellpath misses target center by 827.49ft at 6765.00ft MD (6724.54 TVD, 382.44 N, 357.03 E) - Point	0.00	0.00	7,552.00	389.12	357.77	1,574,247.12	2,286,417.52	39° 22' 58.224 N	108° 1' 29.651 W
SGV Federal 8-11C - actual wellpath misses target center by 12.31ft at 4990.81ft MD (4951.82 TVD, 408.19 N, 418.55 E) - Rectangle (sides W25.00 H25.00 D0.00)	0.00	360.00	4,952.00	414.12	407.77	1,574,272.12	2,286,467.52	39° 22' 58.485 N	108° 1' 29.023 W
SGV Federal 8-11C - actual wellpath misses target center by 63.70ft at 4991.07ft MD (4952.07 TVD, 408.18 N, 418.55 E) - Rectangle (sides W100.00 H200.00 D2,600.00)	0.00	0.00	4,952.00	389.12	357.77	1,574,247.12	2,286,417.52	39° 22' 58.224 N	108° 1' 29.651 W

North Reference Sheet for Sec. 8-T8S-R95W (SGV 8D PAD) - SGV Federal 8-11C - Plan #2

All data is in US Feet unless otherwise stated. Directions and Coordinates are relative to Grid North Reference.

Vertical Depths are relative to RKB 24' @ 6365.70ft (H&P 322). Northing and Easting are relative to SGV Federal 8-11C - Slot A11

Coordinate System is US State Plane 1983, Colorado Central Zone using datum North American Datum 1983, ellipsoid GRS 1980

Projection method is Lambert Conformal Conic (2 parallel)

Central Meridian is 105° 30' 0.000 W°, Longitude Origin:0° 0' 0.000 E°, Latitude Origin:39° 45' 0.000 N°

False Easting: 3,000,000.00ft, False Northing: 1,000,000.00ft, Scale Reduction: 0.99994788


Grid Coordinates of Well: 1,573,858.02 ft N, 2,286,059.77 ft E


Geographical Coordinates of Well: 39° 22' 54.28" N, 108° 01' 34.07" W

Grid Convergence at Surface is: -1.59°

Based upon Minimum Curvature type calculations, at a Measured Depth of 6,765.00ft
the Bottom Hole Displacement is 523.20ft in the Direction of 43.03° (Grid).

Magnetic Convergence at surface is: -12.04° (30 September 2010, , BGGM2010)

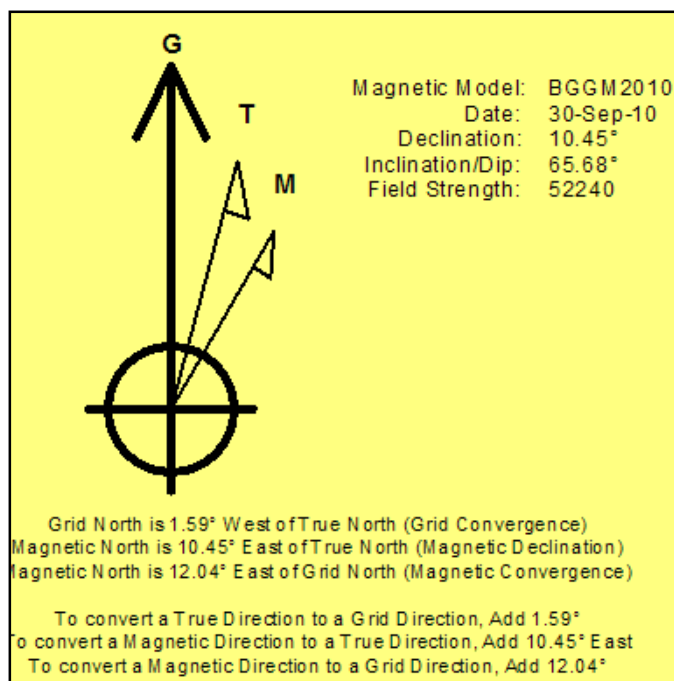


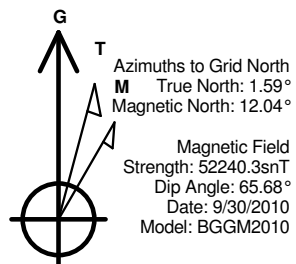

LEGEND

- SGV Federal 8-11C, Plan #2, Plan #2 Proposal V0
- Gyro and Sperry MWD Survey


Halliburton Energy Services, Inc. ("Halliburton") recently completed directional drilling and MWD operations at the SGV Federal 8-11C well located at Garfield County, CO. At the conclusion of the job Halliburton performed a final survey on the well. Noble Energy has requested that Halliburton provide them the distances from BHL to section lines from that final survey to allow Noble Energy to meet its requirements under Colorado law. These distances are generated by a mathematical algorithm based on rough data collected after the well is drilled. Halliburton considers it to be a rough estimate only and it is not to be relied upon in any application where accurate data is required. In consideration for Halliburton releasing this data to Noble Energy, Noble Energy agrees to release Halliburton from any consequences of it or anyone else relying on such data.

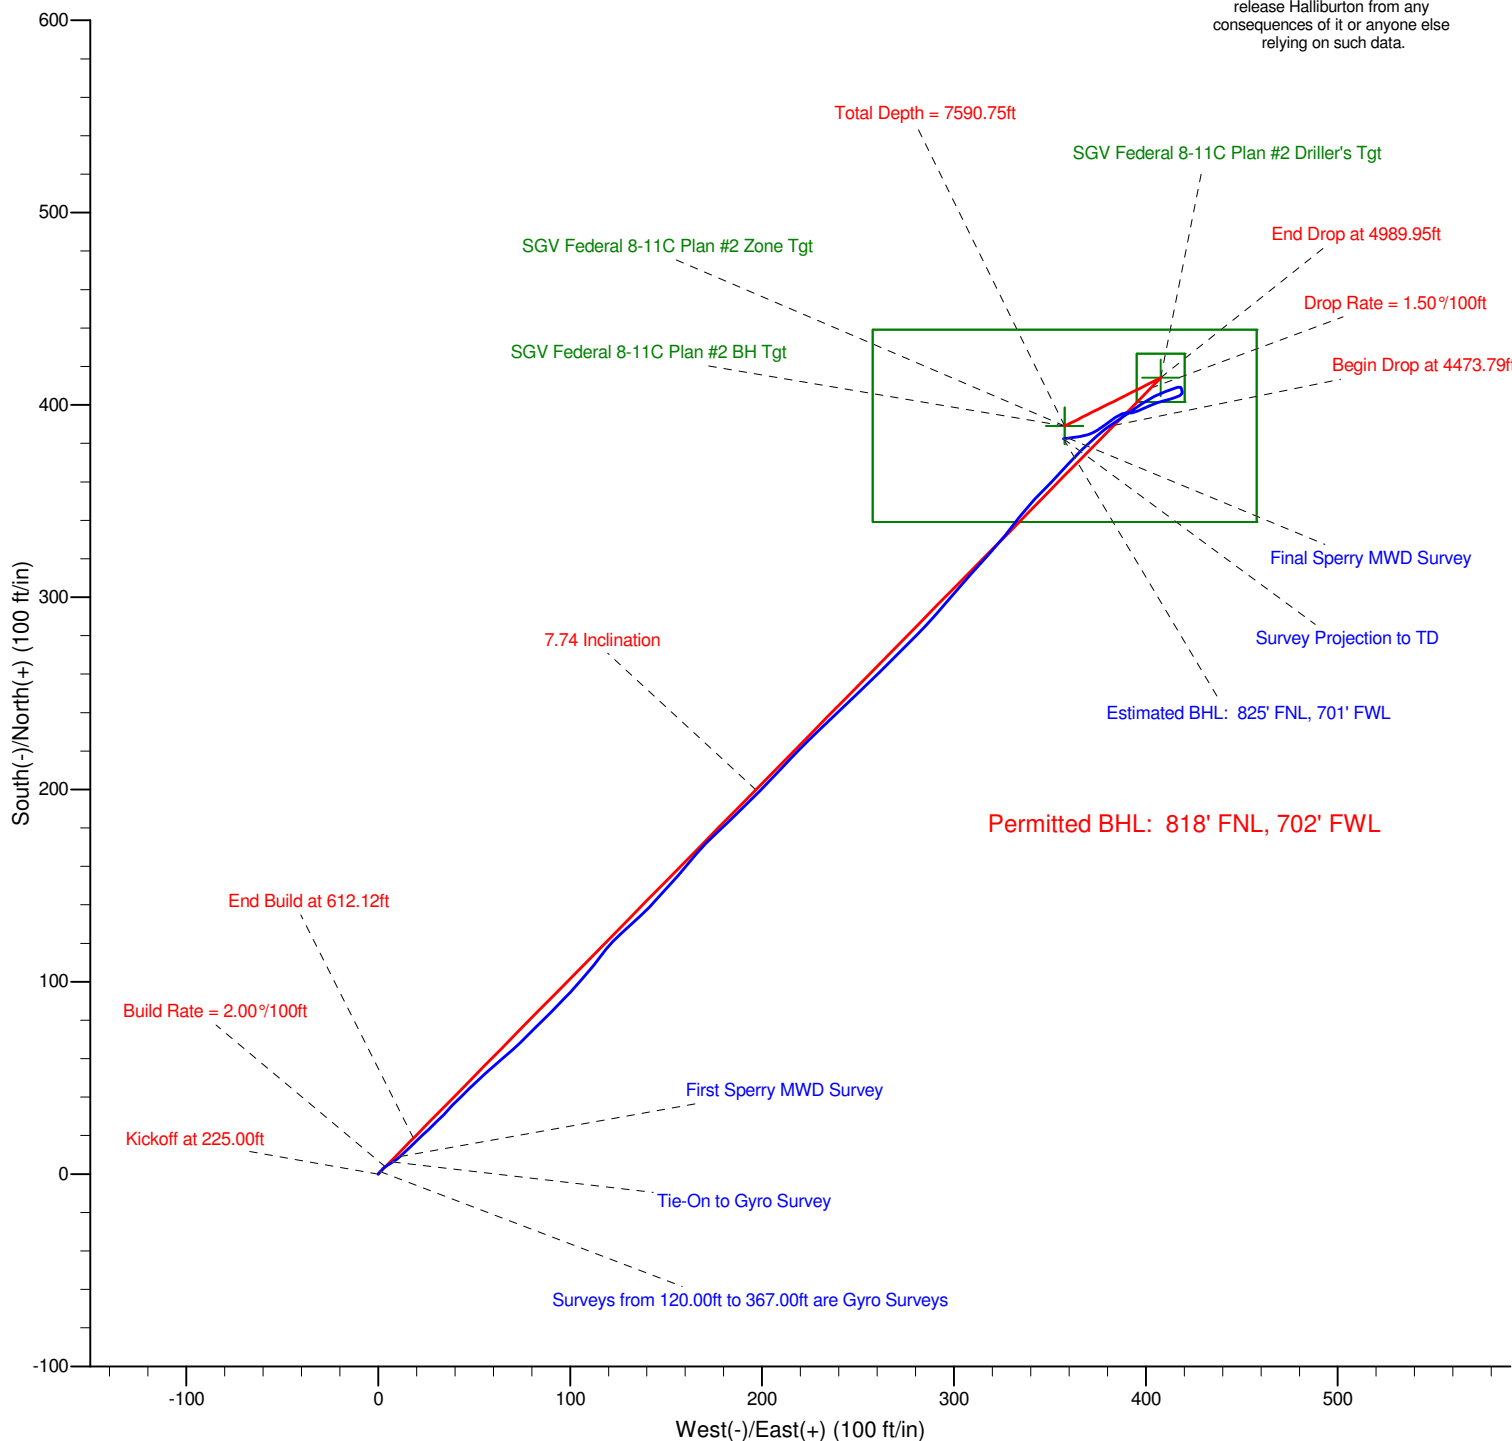

Noble Energy

HALLIBURTON

Sperry Drilling

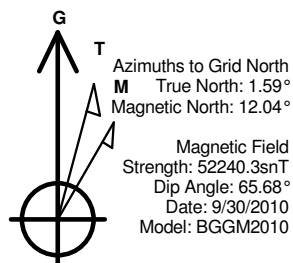

LEGEND

- SGV Federal 8-11C, Plan #2, Plan #2 Proposal V0
- Gyro and Sperry MWD Survey

Halliburton Energy Services, Inc. ("Halliburton") recently completed directional drilling and MWD operations at the SGV Federal 8-11C well located at Garfield County, CO. At the conclusion of the job Halliburton performed a final survey on the well. Noble Energy has requested that Halliburton provide them the distances from BHL to section lines from that final survey to allow Noble Energy to meet its requirements under Colorado law. These distances are generated by a mathematical algorithm based on rough data collected after the well is drilled. Halliburton considers it to be a rough estimate only and it is not to be relied upon in any application where accurate data is required. In consideration for Halliburton releasing this data to Noble Energy, Noble Energy agrees to release Halliburton from any consequences of it or anyone else relying on such data.

