




SECTION DETAILS										
MD	Inc	Azi	TVD	+N/-S	+E/-W	DLeg	TFace	VSec	Annotation	
0.00	0.00	0.00	0.00	0.00	0.00	0.00	0.00	0.00	Start Build 3.50	
2000.00	0.00	0.00	2000.00	0.00	0.00	0.00	0.00	0.00	Start 412.10 hold at 3167.87 MD	
3167.87	40.88	146.34	3071.30	-332.29	221.27	3.50	146.34	399.21	TD at 3579.97	
3579.97	40.88	146.34	3382.80	-556.76	370.74	0.00	0.00	668.90		

WELL DETAILS: LAKE 34-29										
+N/-S	+E/-W	Northing	Ground Level:	Eastings	Latitude	Longitude	Slot			
0.00	0.00	1192533.22	5370.00	3105343.85	38° 21' 41.022 N	105° 7' 57.454 W				

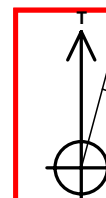

Azimuths to True North
 Magnetic North: 8.99°

Magnetic Field
 Strength: 52070.4nT
 Dip Angle: 65.37°
 Date: 6/16/2010
 Model: BGGM2010

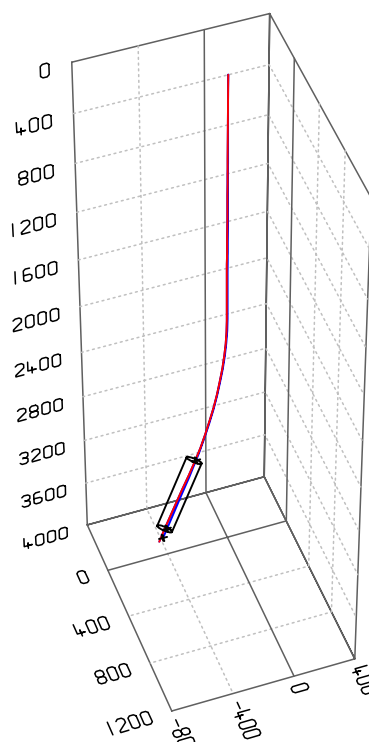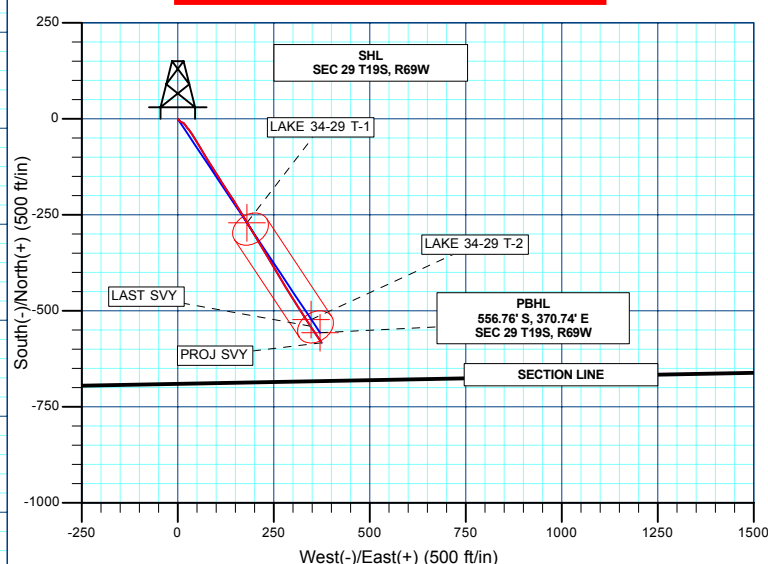

Survey: Survey #1 (LAKE 34-29/LAKE 34-29)

Created By: TRACY WILLIAMS Date: 8:55, November 08 2010