



SECTION DETAILS										
MD	Inc	Azi	TVD	+N-S	+E-W	DLeg	TFace	VSec	Annotation	
1700.00	0.00	0.00	1700.00	0.00	0.00	0.00	0.00	0.00	Start Build 3.50	
3186.39	52.02	343.90	2990.41	605.00	-174.63	3.50	343.90	629.70	Start 655.48 hold at 3186.39 MD	
3851.87	52.02	343.90	3399.90	1109.00	-320.10	0.00	0.00	1154.27	TD at 3851.87	

WELL DETAILS: WOOLY BUGGER 34-20										
+N-S	+E-W	Northing	Ground Level:	Eastings	Latitude	Longitude	Slot			
0.00	0.00	1198085.12	5245.00	3105289.30	38° 22' 35.904 N	105° 7' 57.857 W				



Azimuths to True North
 Magnetic North: 8.98°

Magnetic Field
 Strength: 52075.7nT
 Dip Angle: 65.38°
 Date: 6/29/2010
 Model: BGGM2010

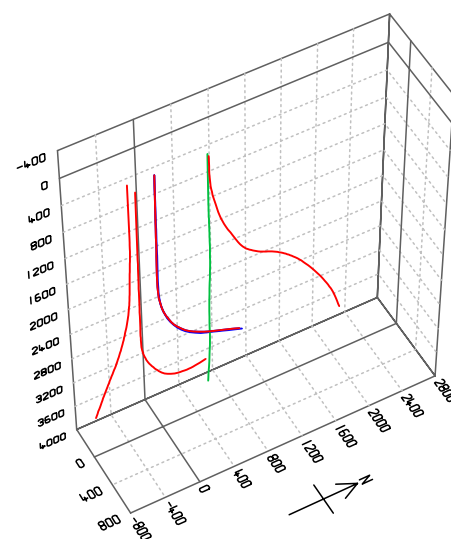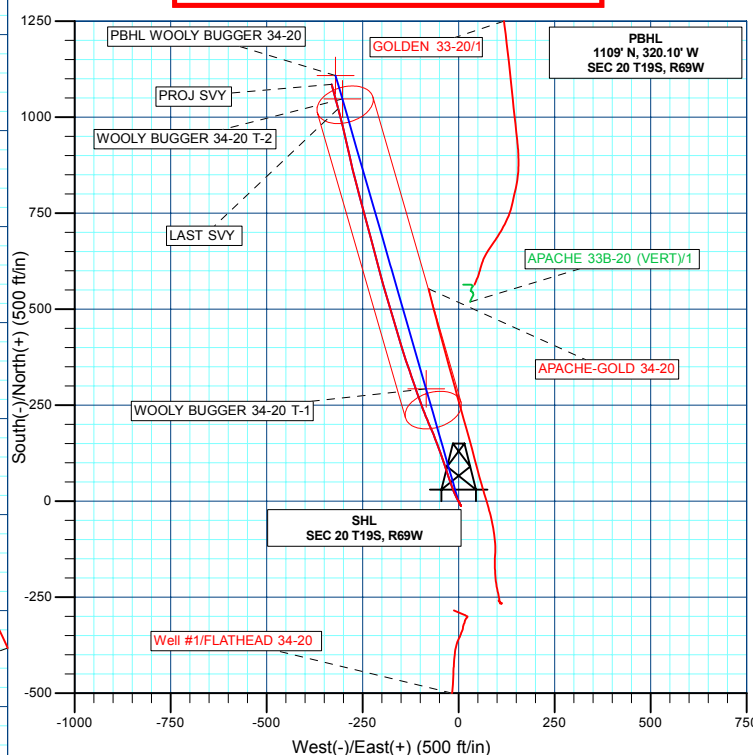

Survey: Survey #1 (WOOLY BUGGER 34-20/WOOLY BUGGER 34-20)

Created By: TRACY WILLIAMS Date: 9:06, November 08 2010