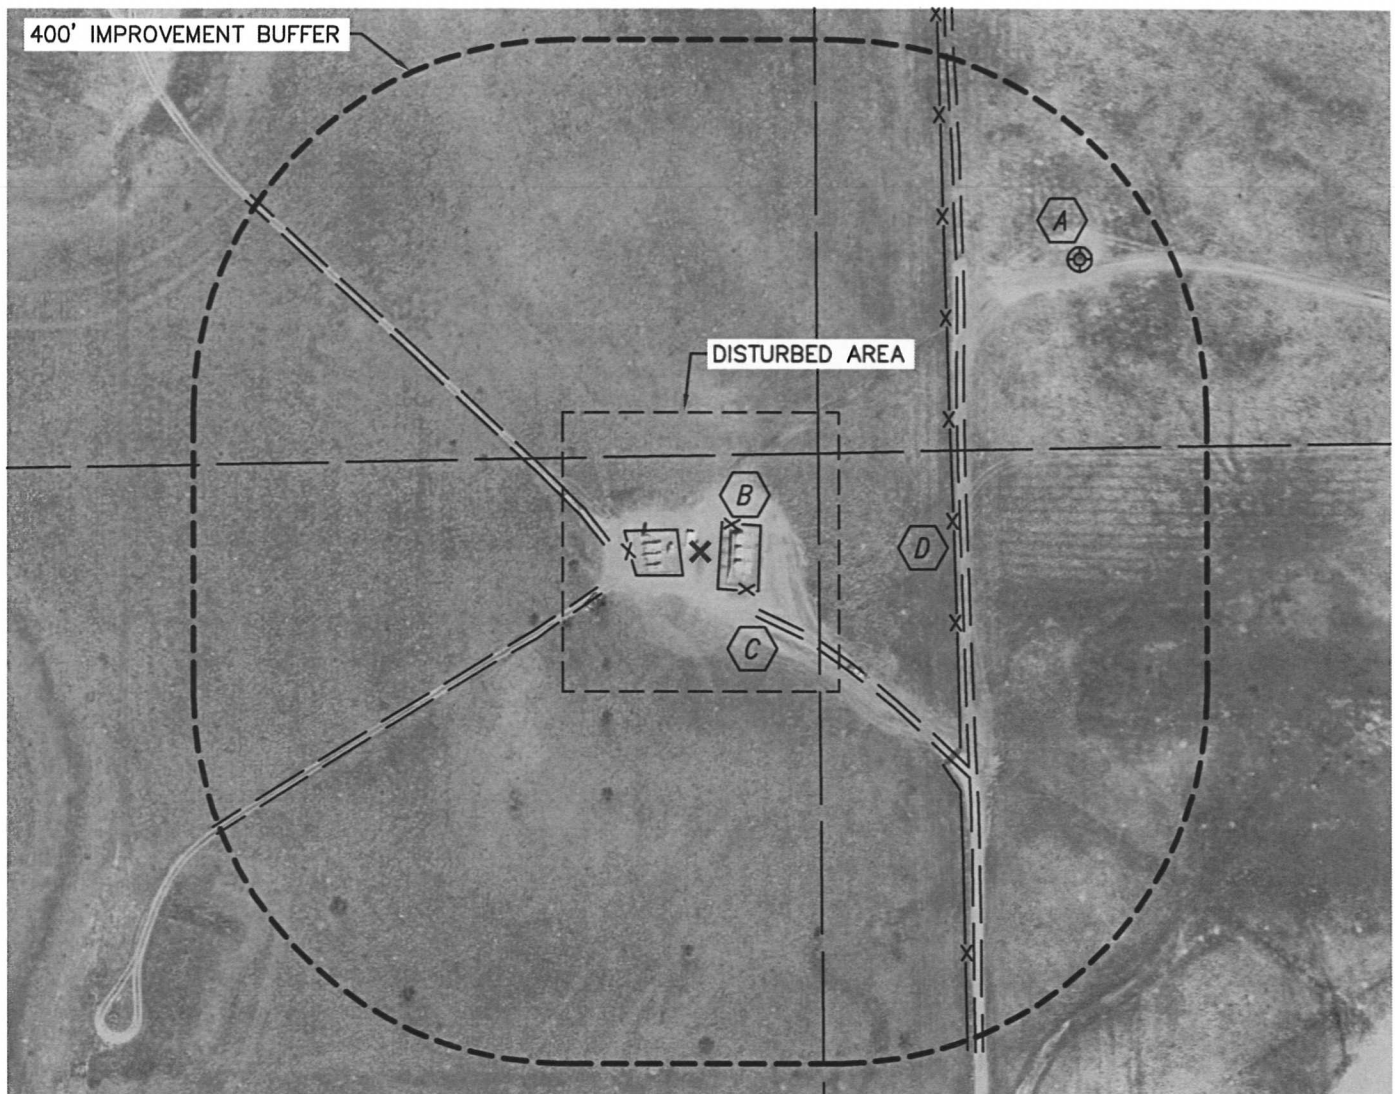


PRODUCTION FACILITY LOCATION DRAWING

SECTION: 13
TOWNSHIP: 2N
RANGE: 66W

WARNER W13-11



REFERENCE POINT LOCATION:

LATITUDE: 40.13443°N
LONGITUDE: 104.73059°W
ELEV: 5078'
PDOP: 1.5
DATE: 2-25-11
OPERATOR: BRIAN BRINKMAN
1/41/4: SW1/4SW1/4
FSL: 1229'
FWL: 1196'

DISTANCE TO WELL: 1226'

ASSOCIATED NEW WELLS:



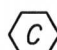

WARNER W13-11

ASSOCIATED EXISTING WELLS:


UPRC 13-110, RLW W13-12JI

RLW W13-13JI, RLW W13-14JI

IMPROVEMENTS:

-  EX. UPRC 13-110 519' NE
-  EXISTING EQUIPMENT 21' E, 22' W
-  FIELD ROAD, 91' SE, 117' SW, 103' NW, 283' E
-  FENCE 176' E

LEGEND

 - REFERENCE POINT
ALL DISTANCES ARE APPROXIMATE.

NEAREST: BUILDING 2030' SE,
PUBLIC ROAD (CR 20) 1215' S, ABOVE GROUND UTILITY 2155' SE,
RAILROAD 5280'+, PROPERTY LINE 1196' W

