


WELL LOCATION CERTIFICATE


THIS MAP DOES NOT REPRESENT A BOUNDARY SURVEY

SECTION: 31
TOWNSHIP: 2N
RANGE: 65W

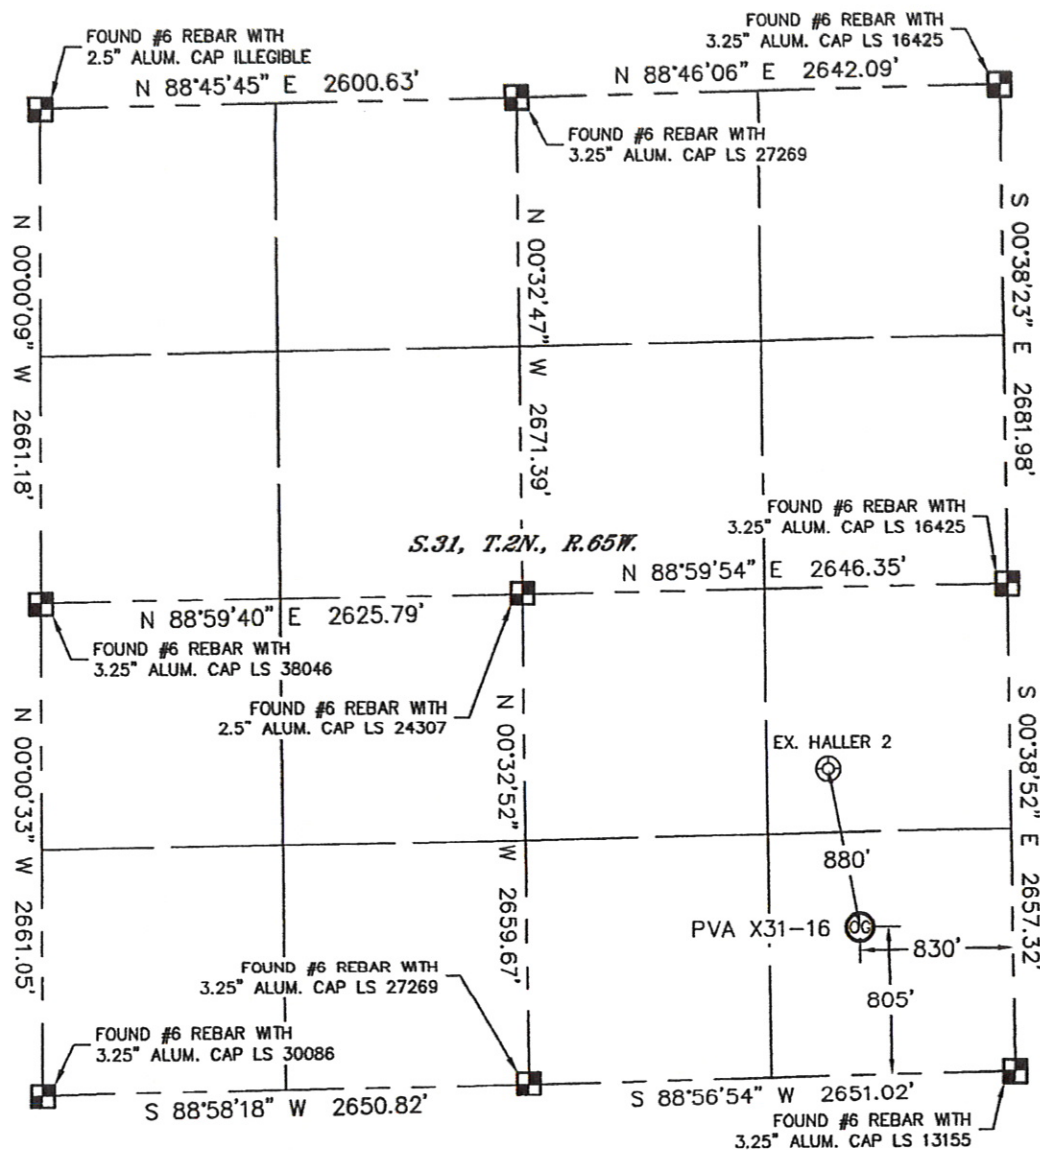

In accordance with a request from Mike Rodine with Noble Energy Inc., Lat40°, LLC has determined the surface location of the PVA X31-16 to be 805' from the SOUTH line and 830' from the EAST line as measured at right angles from the section lines of Section 31, Township 2 North, Range 65 West of the Sixth Principal Meridian, County of Weld, State of Colorado.

I hereby state that this Well Location Certificate was prepared by me, or under my direct supervision, that the fieldwork was completed on 1/7/11, for and on behalf of Noble Energy Inc.. That this is not a Land Survey Plat or an Improvement Survey Plat, and that it is not to be relied upon for establishment of fence, building, or other future improvement lines.

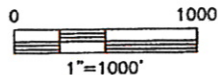

NOTE:

- 1) Bearings shown are Grid Bearings of the Colorado State Plane Coordinate System, North Zone, North American Datum 1983/2007. The lineal dimensions as contained herein are based upon the "U.S. Survey Foot."
- 2) Ground elevations are based on an observed GPS elevation (NAVD 1988 DATUM).
- 3) NEAREST EXISTING WELL: HALLER 2, 880'
- 4) IMPROVEMENTS: See LOCATION DRAWING for all visible improvements within 400' of disturbed area.
- 5) SURFACE USE: RANGELAND
- 6) INSTRUMENT OPERATOR: ADAM KELLY

SURFACE LOCATION
LATITUDE: 40.08977N
LONGITUDE: 104.70007W
PDOP: 1.4
ELEV: 4977'
1/4, 1/4: SE1/4SE1/4
NEAREST PROPERTY LINE: 155' SOUTH



NOTE

According to Colorado law, you must commence any legal action based upon any defect in this W.L.C. within three years after you discover such defect. In no event, may any action based upon any defect in this survey be commenced more than ten years after the date of the certificate shown hereon. (13-80-105 C.R.S.)

LEGEND


- = ALIQUOT MONUMENT AS DESCRIBED
- = CALCULATED POSITION

Brian T. Brinkman—On behalf of Lat40°, LLC
Colorado Licensed Professional
Land Surveyor No. 38175 PROJECT#: 2010182

SITE SKETCH

PVA X31-16

SECTION: 31
TOWNSHIP: 2N
RANGE: 65W

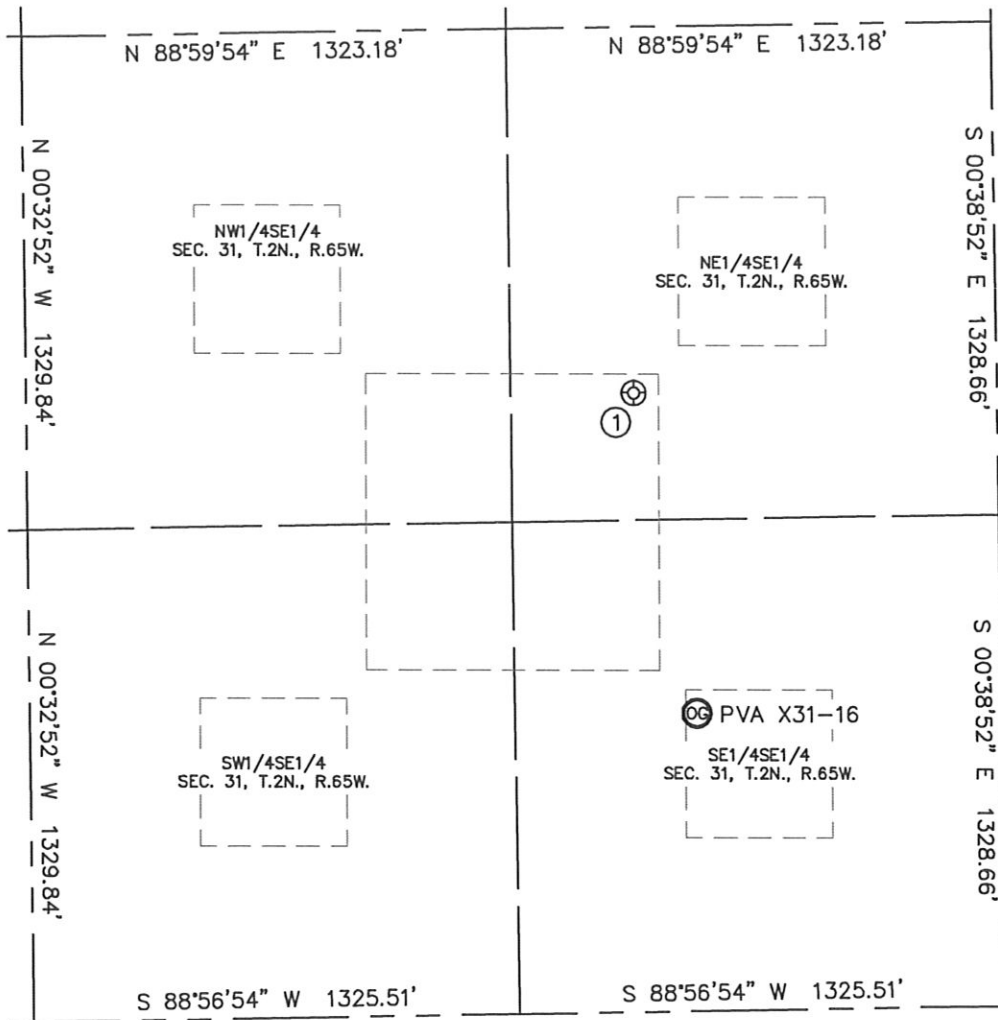

①
HALLER 2
NE1/4SE1/4
1672' FSL
989' FEL
LAT-40.09214°N
LONG-104.70065°W
PDOP: 1.9
ELEV: 4968'

