

KPK
K.P. Kauffman Co., Inc.

SUPERVISOR Rick Ramos

DATE 3/18/11

Well Name Lanson Farms #12

Road Dir:

L. Desc: NWSE

County: Weld, CO

123-08735

Section 35


Township 2N

Range 68W

Meridian 6

Sfc Casing: 8-5/8" 24# 618
Prod Casing: 4.5" 10.5# 5125
Cement top: Est. @3400
flag jt: n/a
PBD: 5089
TD: 5125

30SKS@Surf.

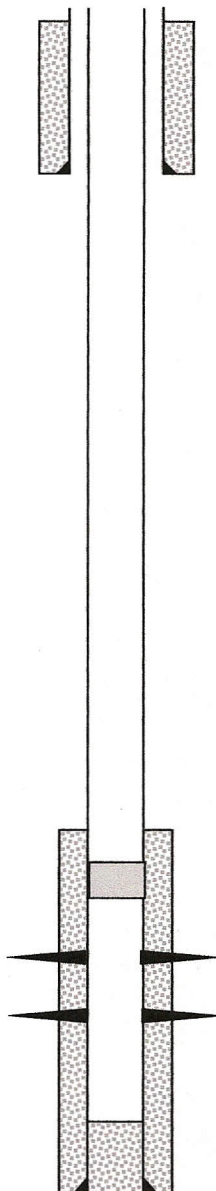


Surf. Csg: 618

Cement top: Est. @3400

Top Perf: 4594
Bottom Perf: 4624
Top Perf: 5014
Shannon Bottom Perf: 5034


PBD: 5089
4.5 Casing: 5125
TD: 5125

120SKS 3%CaCl
From 844
To 565

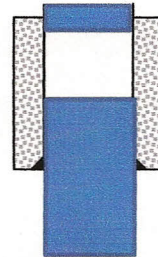

Surf. Csg: 618

50SKS From
2752 To 2652

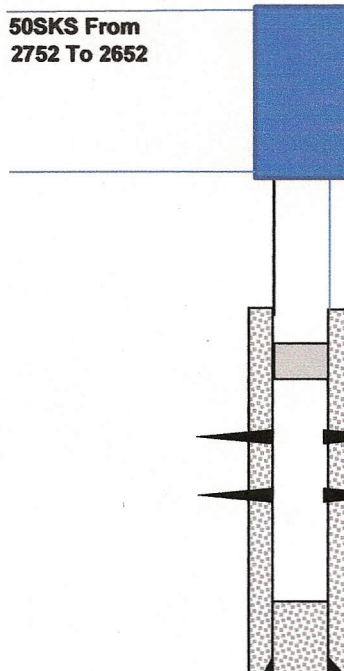

CSG. TOP@2692

Cement top: Est. @3400

Top Perf: 4594
Sussex Bottom Perf: 4624
Top Perf: 5014
Shannon Bottom Perf: 5034

PBD: 5089
4.5 Casing: 5125
TD: 5125

CIBB@4530With2SKS