
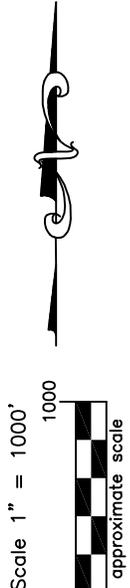


# WELL LOCATION CERTIFICATE

THIS MAP DOES NOT  
 REPRESENT A BOUNDARY SURVEY

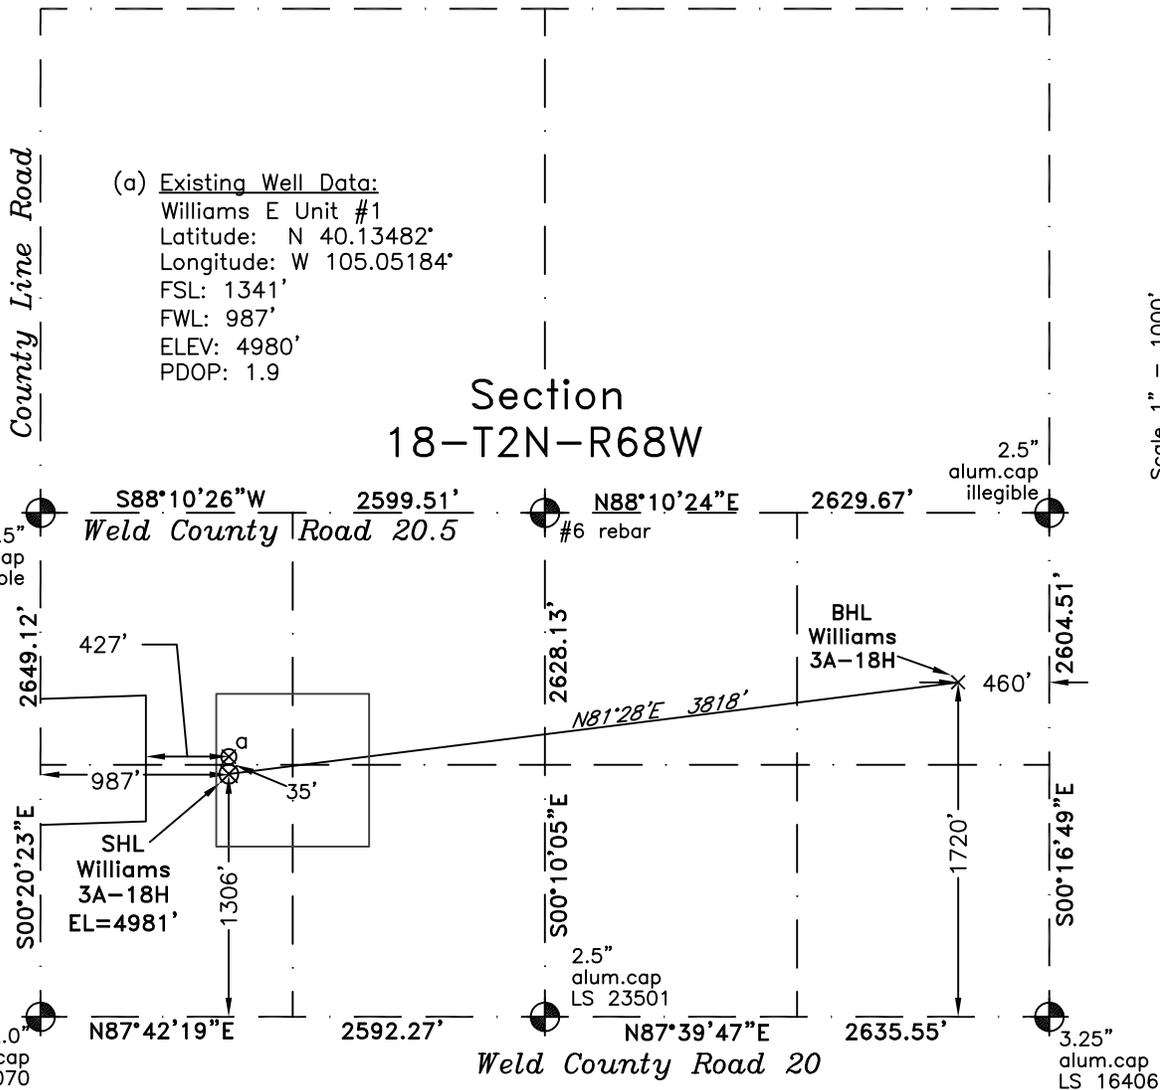

LEGEND  
 - - found survey monument  
 (c) - calculated dimension

In accordance with a request from Dan Nelson of EnCana Oil & Gas (USA) Inc., PLS Group, LLC has determined the location of the **Williams 3A-18H** well site to be SHL: 1306' FSL and 987' FWL, (BHL 1720' FSL and 460' FEL) as measured at ninety (90) degrees from the section lines of Section 18, Township 2 North, Range 68 West, 6th Principal Meridian, County of Weld, CO.

Proposed Surface Hole Data:

Latitude: N 40.13473' BHL(40.13623')  
 Longitude: W 105.05184' BHL(105.03832')  
 PDOP: 1.9

Nearest: Building 540' southwest Above Ground Utility 967' west  
 Public Road 978' west Railroad 10,700' northwest  
 Property Line: 427' west Well Window: SHL is 90' inside  
 Existing Well: Williams E Unit #1 35' north

Notes:

- 1) Bearings and distances based on NAD 83 Colorado North State Plane Coordinates using RTK GPS observations taken 3/11/11 by operator Craig Burke.
- 2) Conversion factor to ground (1.000276491).
- 3) Elevations based on NAVD 88 GPS heights and Geoid 2003 corrections.
- 4) See improvement map for visible improvements within 400 feet of pad site.
- 5) The surface use is agricultural field.

**NOTICE:** According to Colorado law you must commence any legal action based upon any defect in this W.L.C. within three years after you first discover such defect. In no event may any action based upon any defect in this W.L.C. be commenced more than ten years from this said date of the certification shown hereon.

I hereby certify that this Well Location Certificate was prepared by me or under my direct supervision on 3/22/11 for and on behalf of EnCana Oil & Gas (USA) Inc. That it is not a Land Survey Plat or an Improvement Survey Plat and that it is not to be relied upon for establishment of fences, buildings, or other future improvement lines.

John Robert McGehee LS#38219  
 Well: Williams 3A-18H WLC