

Rangely Weber Sand Unit

OLDLAND ERNEST 5X Plugged and Abandoned Wellbore

03/04/11

Well Details:	
STATE & CO	CO - Rio Blanco
TWNS & RNG	T2N & R102W
SECTION	(SWSE) 36
API	05-103-0853600
CHEVNO	DL1154

Casing Details:	P&A: OLD5X - CS39
Type	Depth
KB	5238
GL	5224
16 in. #/ft, UNKNOWN	0 - 40', UNKNOWN sxs cmt
9.625 in. 36 #/ft, K-55	0 - 785', 515 sxs cmt
7 in. 23 #/ft, K-55	0 - 5324', 375 sxs cmt
7 in. 23 #/ft, N-80	5324 - 5831', sxs cmt
7 in. 23 #/ft, N-80	5831 - 6478', 250 sxs cmt
Perfs, Top:	5942
Perfs, Top:	5942
Perfs, Btm:	6410
PBTD:	6450
TD:	6478

Formation	Depth
Niobrara	2216
Frontier	3080
Frontier Snd	3164
Mowry	3348
Dakota	3440
Morrison	3530
Curtis	4110
Entrada	4231
Carmel	4404
Navajo	4457
Chinle	5060
Shinarump	5210
Moenkopi	5280
Weber	5928

GOC_CALC	5568
----------	------

Weber 1a	5927
Weber 2	6100
Weber 3a	6110
Weber 4	6201
Weber 5a	6234
Weber 6	6343
Weber 7a	6352
Weber 8	0
Weber 9a	0
Weber 10	0
Weber 11a	0

OWC_CALC	6338
----------	------

KB 5238

GL 5224

16 in. #/ft, UNKNOWN
0 - 40', UNKNOWN sxs cmt

9.625 in. 36 #/ft, K-55
0 - 785', 515 sxs cmt

7 in. 23 #/ft, K-55
0 - 5324', 375 sxs cmt

7 in. 23 #/ft, N-80
5324 - 5831', sxs cmt

7 in. 23 #/ft, N-80
5831 - 6478', 250 sxs cmt

Perfs, Top:
5942


Weber 5928

Perfs, Top: 5942

Perfs, Btm: 6410

PBTD: 6450

TD: 6478

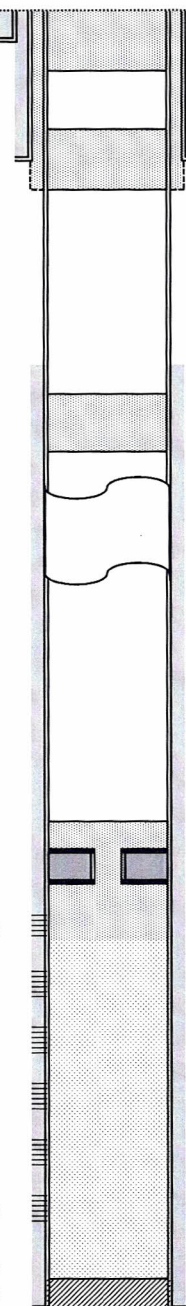

Cement Plug	Depths	BBIs	Sxs
Surface Plug	0 - 250'	10	48
Shoe & Annular Plugs	0 - 910'	3	14
7", 23#/ft	660 - 910'	10	48
TOC @ 1400 Intermediate Plug	1875 - 2125'	10	48
Cement above CICR	5753 - 5878'	5	24
7" CICR @	5878		
Cement below CICR	5878 - 6003'	5	24
Total Cement		BBIs	Sxs
Minimum Weber Plug	10%/1000'	49	235
Full Plug to PBTD	10%/1000'	78	375

Notes:

- 1-
- 2-
- 3-