



WELL LOCATION CERTIFICATE

SECTION: 2
TOWNSHIP: 4N
RANGE: 65W

THIS MAP DOES NOT REPRESENT A BOUNDARY SURVEY

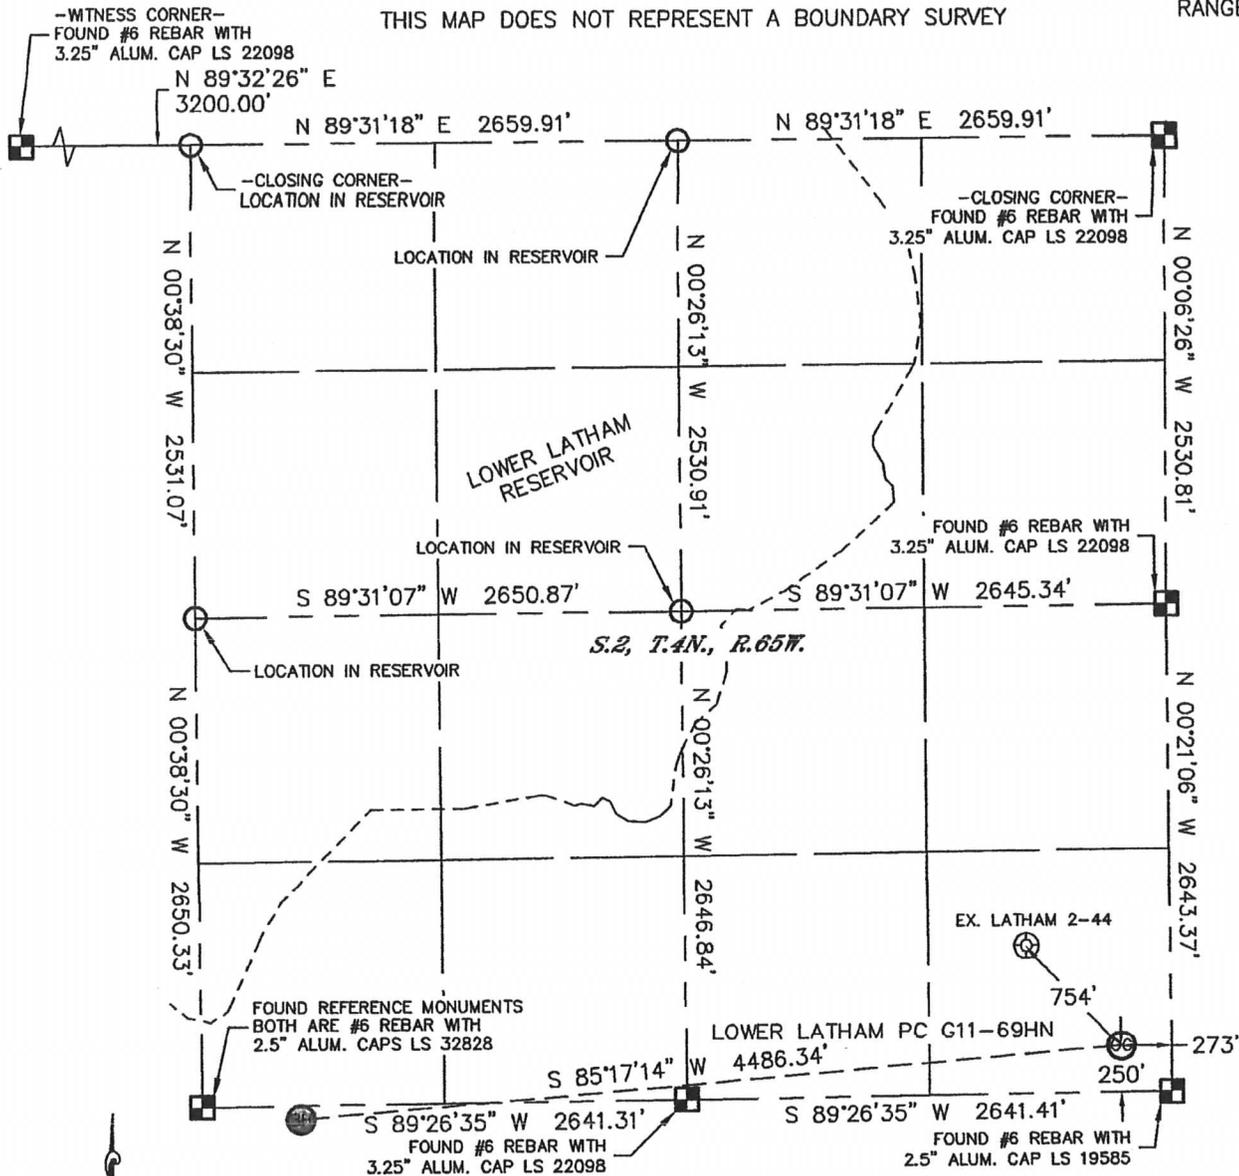


In accordance with a request from Brian Derose with Noble Energy Inc. Lat40°, LLC has determined the surface location of the LOWER LATHAM PC G11-69HN to be 250' from the SOUTH line and 273' from the EAST line as measured at right angles from the section lines of Section 2, Township 4 North, Range 65 West and the bottom hole to be 75' from the NORTH line and 535' from the WEST line as measured at right angles from the section lines of Section 11, Township 4 North, Range 65 West of the Sixth Principal Meridian, County of Weld, State of Colorado. I hereby state that this Well Location Certificate was prepared by me, or under my direct supervision, that the fieldwork was completed on 12-13-10, for and on behalf of Noble Energy Inc. That this is not a Land Survey Plat or an Improvement Survey Plat, and that it is not to be relied upon for establishment of fence, building, or other future improvement lines.

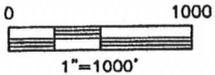

NOTE:

- 1) Bearings shown are Grid Bearings of the Colorado State Plane Coordinate System, North Zone, North American Datum 1983/2007. The lineal dimensions as contained herein are based upon the "U.S. Survey Foot."
- 2) Ground elevations are based on an observed GPS elevation (NAVD 1988 DATUM).
- 3) NEAREST EXISTING WELL: LATHAM 2-44 754'
- 4) IMPROVEMENTS: See LOCATION DRAWING for all visible improvements within 400' of disturbed area.
- 5) SURFACE USE: RANGELAND
- 6) INSTRUMENT OPERATOR: BRIAN BRINKMAN

SURFACE LOCATION	BOTTOM HOLE
LATITUDE: 40.33494°N	LATITUDE: 40.33404°N
LONGITUDE: 104.62193°W	LONGITUDE: 104.63797°W
PPOP: 1.7	
ELEV: 4709	
1/4,1/4: SE1/4SE1/4	
NEAREST PROPERTY LINE: 250' SOUTH	

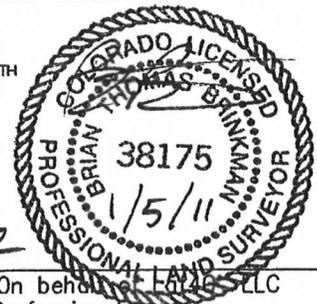

SHEET 1 OF 2

Brian T. Brinkman—On behalf of Lat40°, LLC
Colorado Licensed Professional
Land Surveyor No. 38175 PROJECT#: 2010169

NOTE

According to Colorado law, you must commence any legal action based upon any defect in this W.L.C. within three years after you discover such defect. In no event, may any action based upon any defect in this survey be commenced more than ten years after the date of the certificate shown hereon. (13-80-105 C.R.S.)



LEGEND

-  = ALIQUOT MONUMENT AS DESCRIBED
-  = CALCULATED POSITION

WELL LOCATION CERTIFICATE

THIS MAP DOES NOT REPRESENT A BOUNDARY SURVEY

SECTION: 2
TOWNSHIP: 4N
RANGE: 65W

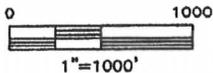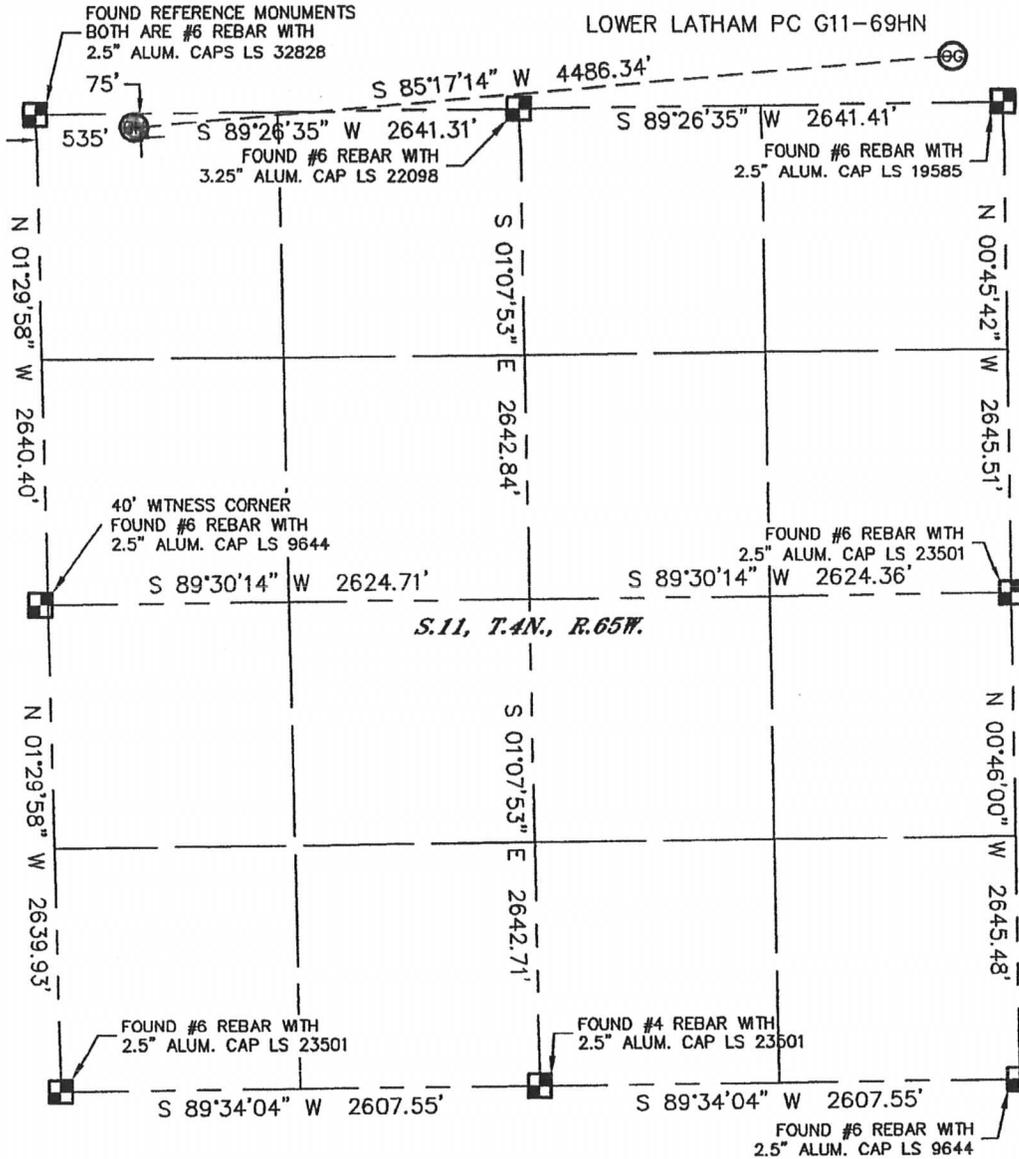

NOTE
According to Colorado law, you must commence any legal action based upon any defect in this W.L.C. within three years after you discover such defect. In no event, may any action based upon any defect in this survey be commenced more than ten years after the date of the certificate shown hereon. (13-80-105 C.R.S.)

LEGEND

-  = ALIQUOT MONUMENT AS DESCRIBED
-  = CALCULATED POSITION



SHEET 2 of 2


Brian T. Brinkman—On behalf of Lat40°, LLC
Colorado Licensed Professional
Land Surveyor No. 38175

PROJECT#: 2010169

SITE SKETCH

LOWER LATHAM PC G11-69HN

SECTION: 2
TOWNSHIP: 4N
RANGE: 65W

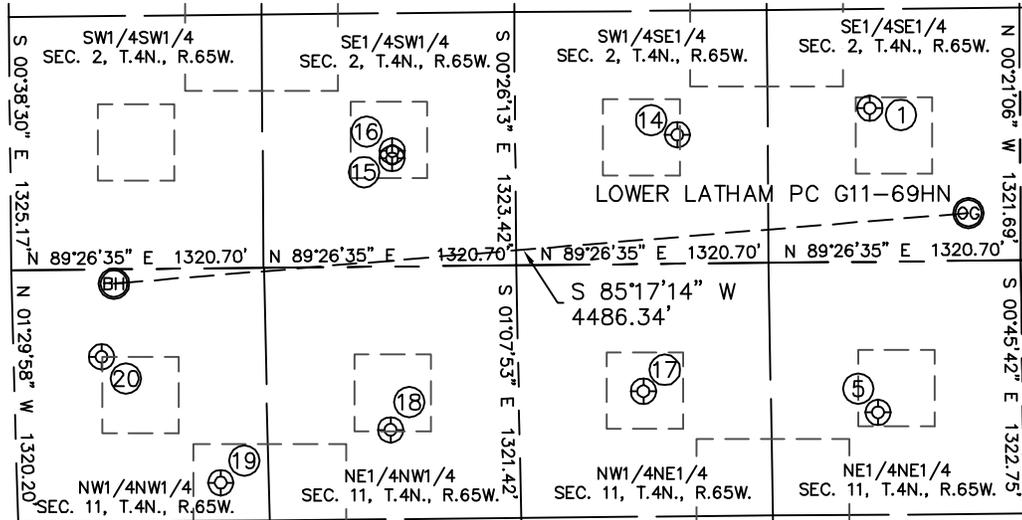

①

LATHAM 2-44
SE1/4SE1/4
804' FSL
786' FEL
LAT-40.33646°N
LONG-104.62376°W
PDOP: 2.3
ELEV: 4701

⑤

HANSCOME 11-7
NE1/4NE1/4
787' FNL
758' FEL
LAT-40.33209°N
LONG-104.62366°W
PDOP: 1.5
ELEV: 4708

⑭

LATHAM 2-43
SW1/4SE1/4
674' FSL
1793' FEL
LAT-40.33610°N
LONG-104.62737°W
PDOP: 2.2
ELEV: 4680

⑮

LATHAM RESERVOIR 1
SE1/4SW1/4
564' FSL
1998' FWL
LAT-40.33580°N
LONG-104.63273°W
PDOP: 2.1
ELEV: 4673

⑯

LATHAM 2-31
SE1/4SW1/4
604' FSL
2000' FWL
LAT-40.33591°N
LONG-104.63273°W
PDOP: 2.1
ELEV: 4673

⑰

HANSCOME 5
NW1/4NE1/4
665' FNL
1984' FEL
LAT-40.33242°N
LONG-104.62806°W
PDOP: 1.3
ELEV: 4684

⑱

HANSCOME 3
NE1/4NW1/4
854' FNL
1962' FWL
LAT-40.33191°N
LONG-104.63281°W
PDOP: 1.3
ELEV: 4675

⑲

HANSCOME 11-415
NW1/4NW1/4
1121' FNL
1066' FWL
LAT-40.33117°N
LONG-104.63600°W
PDOP: 1.3
ELEV: 4676

⑳

HANSCOME G11-4
NW1/4NW1/4
458' FNL
460' FWL
LAT-40.33299°N
LONG-104.63822°W
PDOP: 1.8
ELEV: 4674

