


KING SURVEYORS, INC. 650 E. GARDEN DR. WINDSOR, CO 80550  
**PRODUCTION FACILITY LOCATION DRAWING**  
 VEGA USX A03-05

SECTION: 3  
 TOWNSHIP: 6N  
 RANGE: 64W

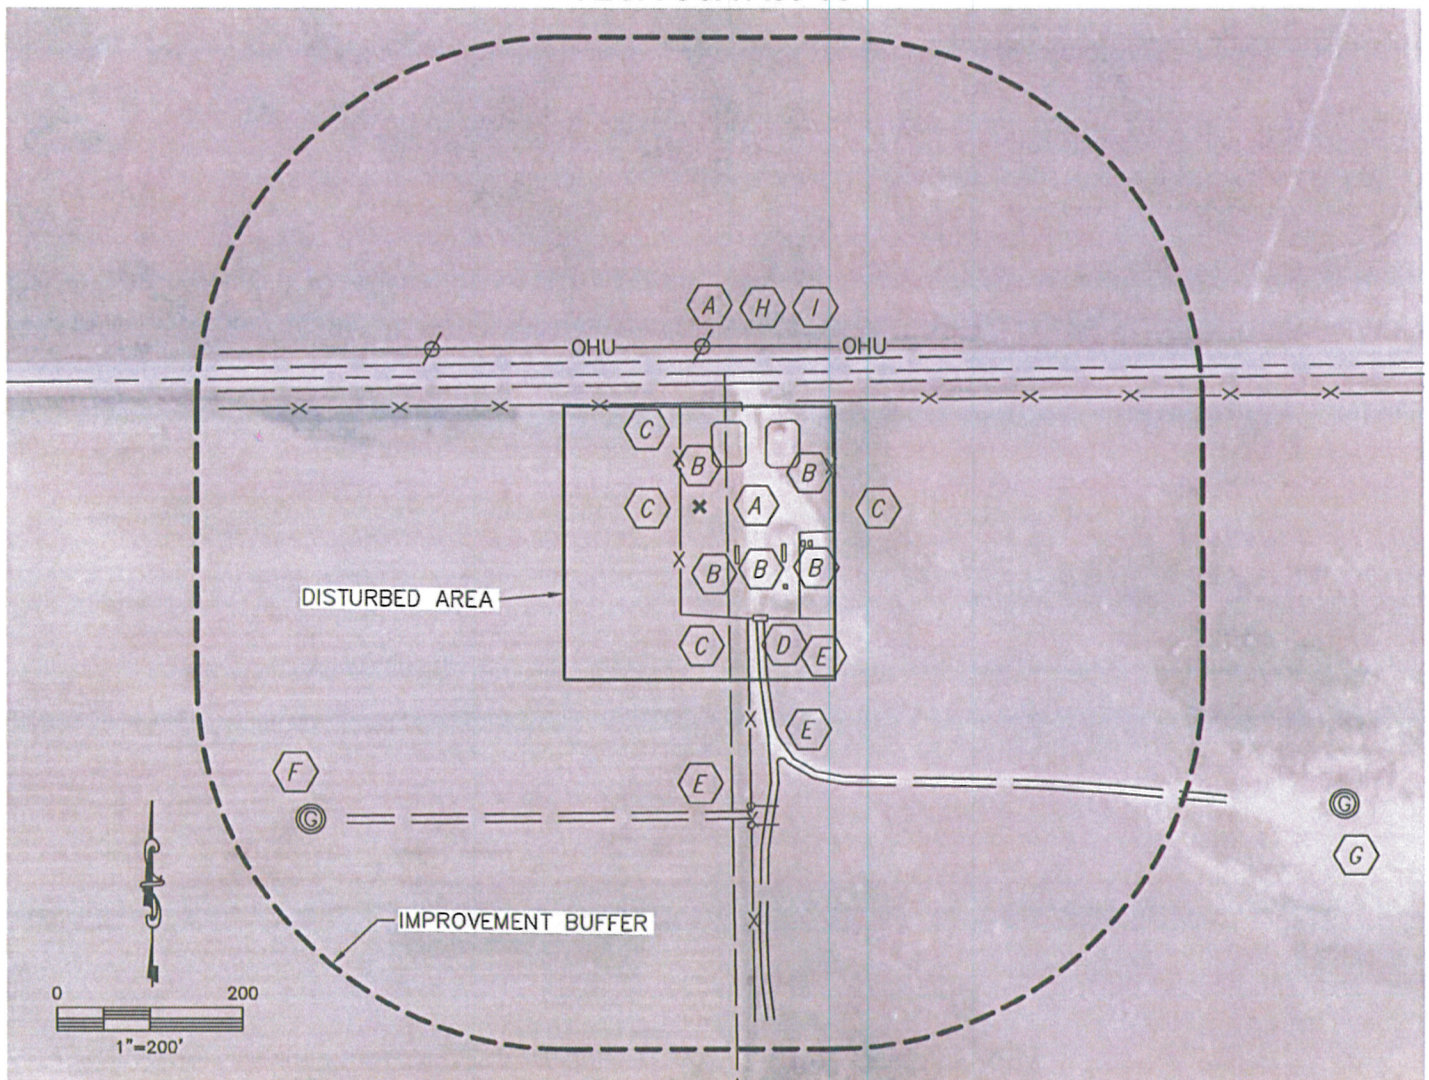

**REFERENCE POINT LOCATION:**

LATITUDE: 40.52208°N  
 LONGITUDE: 104.54106°W  
 ELEV: 4823'  
 PDOP: 1.9  
 DATE: 3/9/2011  
 OPERATOR: RON EDWARDS  
 1/4,1/4: NW1/4 NW1/4  
 FNL: 144'  
 FWL: 1288'  
 DISTANCE TO WELL: 1912' SW  
 ASSOCIATED NEW WELLS:  
 VEGA USX A03-05  
 ASSOCIATED EXISTING WELLS:  
 VEGA 11-3  
 RUFF 21-3  
 RUFF 22-3

- A PROPERTY LINE 30'E, 144'N
- B EXISTING PRODUCTION EQUIPMENT 47'NE, 87'NE, 117'SE, 99'SE, 58'SE, 125'SE
- C FENCE 21'W, 111'N, 146'E, 118'S
- D CATTLE GUARD 131' SE
- E FIELD ROAD 144'SE, 259'S, 339'S
- F EXISTING WELL-VEGA 11-3 542' SW
- G EXISTING WELL-RUFF 21-3 772' SE
- H SOUTH EDGE ASPHALT ROAD 132' N
- I OVERHEAD UTILITY LINE 173' N

**NEAREST**

BUILDING=1002' NE  
 PUBLIC ROAD=132' N  
 ABOVE GROUND UTILITY=173' N  
 RAILROAD=5280'+  
 PROPERTY LINE=30' E

**LEGEND**

× REFERENCE POINT

**NOTE**

ALL DISTANCES  
 ARE APPROXIMATE

PROJECT#: 2011088