


**Attachment #1 – Proposed Wellbore Diagram**

**PROPOSED WELLBORE DIAGRAM**

Operator: Encana Oil & Gas (USA) Inc.  
 Well Name: FEDERAL A-20-3-101-S  
 Lease Number: COC1633  
 Unit Number:  
 Location: NENE Sec.20 -T35 -R101W  
 Field: Cathedral  
 County, State: Rio Blanco, CO  
 API Number: 05-103-08348-0000  
 Diagram Date: As of April 8, 2011

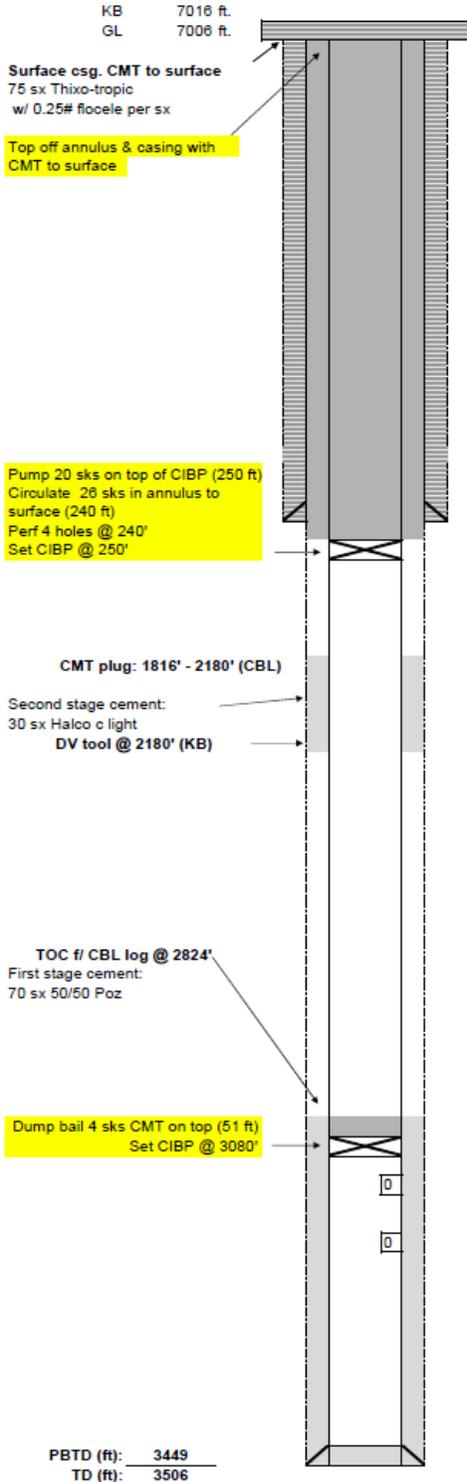

**CASING RECORD**

SIZE (in)	WT (lb/ft)	GRADE	Hole D(in)	TOP (ft)	BTM (ft)	Date Run
7	20	K-55	9 7/8	0	188	09/05/1979
4 1/2	10.5	assumed K-55	6 1/2	0	3,501	09/09/1979

**TUBING RECORD**

SIZE (in)	WT (lb/ft)	GRADE	TOP (ft)	BTM (ft)	Date Run

**JEWELRY RECORD**

ITEM	MAKER	SIZE (in)	Max ID	TOP (ft)	Date Run

**PERFORATION RECORD**

ZONE	TOP (ft)	BTM (ft)	SPF	Holes	Date Shot
Mancos B	3144	3355		24	09/27/1979


**COMMENTS/HISTORY:**

09/05/1979 Spud date.  
 09/08/1979 TD reached.  
 10/01/1979 Perforated Mancos B  
 3,144 ft – 3,355 ft  
 25 holes  
 Fractured Mancos B  
 292,000 lb 20/40 sand  
 108,000 lb 10/20 sand  
 880 MCF N2 (450 SCF/BBL fluid)  
 82,400 gal fluid  
 04/01/1994 Sundry filed; well returned to production this date.

# Attachment #2 – Current Wellbore Diagram

## CURRENT WELLBORE DIAGRAM

Operator: Encana Oil & Gas (USA) Inc.  
 Well Name: FEDERAL A-20-3-101-S  
 Lease Number: COC1633  
 Unit Number:  
 Location: NENE Sec.20 -T35 -R101W  
 Field: Cathedral  
 County, State: Rio Blanco, CO  
 API Number: 05-103-08348-0000  
 Diagram Date: As of April 6, 2011

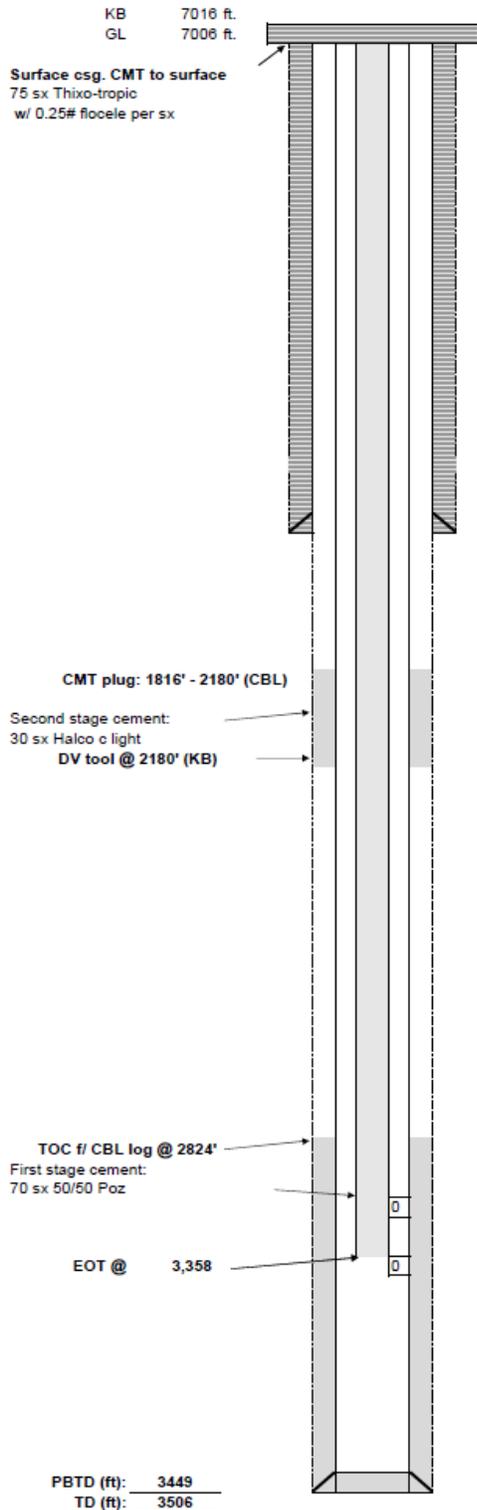

### CASING RECORD

SIZE (in)	WT (lb/ft)	GRADE	Hole D(in)	TOP (ft)	BTM (ft)	Date Run
7	20	K-55	9 7/8	0	188	09/05/1979
4 1/2	10.5	assumed K-55	6 1/2	0	3,501	09/09/1979

### TUBING RECORD

SIZE (in)	WT (lb/ft)	GRADE	TOP (ft)	BTM (ft)	Date Run	
2 1/16	3.25	assumed J-55		0	3,358	08/12/1994

### JEWELRY RECORD

ITEM	MAKER	SIZE (in)	Max ID	TOP (ft)	Date Run

### PERFORATION RECORD

ZONE	TOP (ft)	BTM (ft)	SPF	Holes	Date Shot
Mancos B	3144	3355		24	09/27/1979

### COMMENTS/HISTORY:

09/05/1979 Spud date.  
 09/08/1979 TD reached.  
 10/01/1979 Perforated Mancos B  
 3,144 ft – 3,355 ft  
 25 holes  
 Fractured Mancos B  
 292,000 lb 20/40 sand  
 108,000 lb 10/20 sand  
 880 MCF N2 (450 SCF/BBL fluid)  
 82,400 gal fluid  
 04/01/1994 Sundry filed; well returned to production this date.