

Downhole Schematic for N Parachute WF08D-21 K22 596



Project :North Piceance

API # :05045188970000

Surface Location :NESW Sec 22 T5S - R96W 6th P

Area : N Parachute

County :


BHL : SENE-21-5S-96 W 6th PM

As Of : 02/05/2011

GL : 6526.0 ft

KB to GL : ft

KB : 0.0 ft

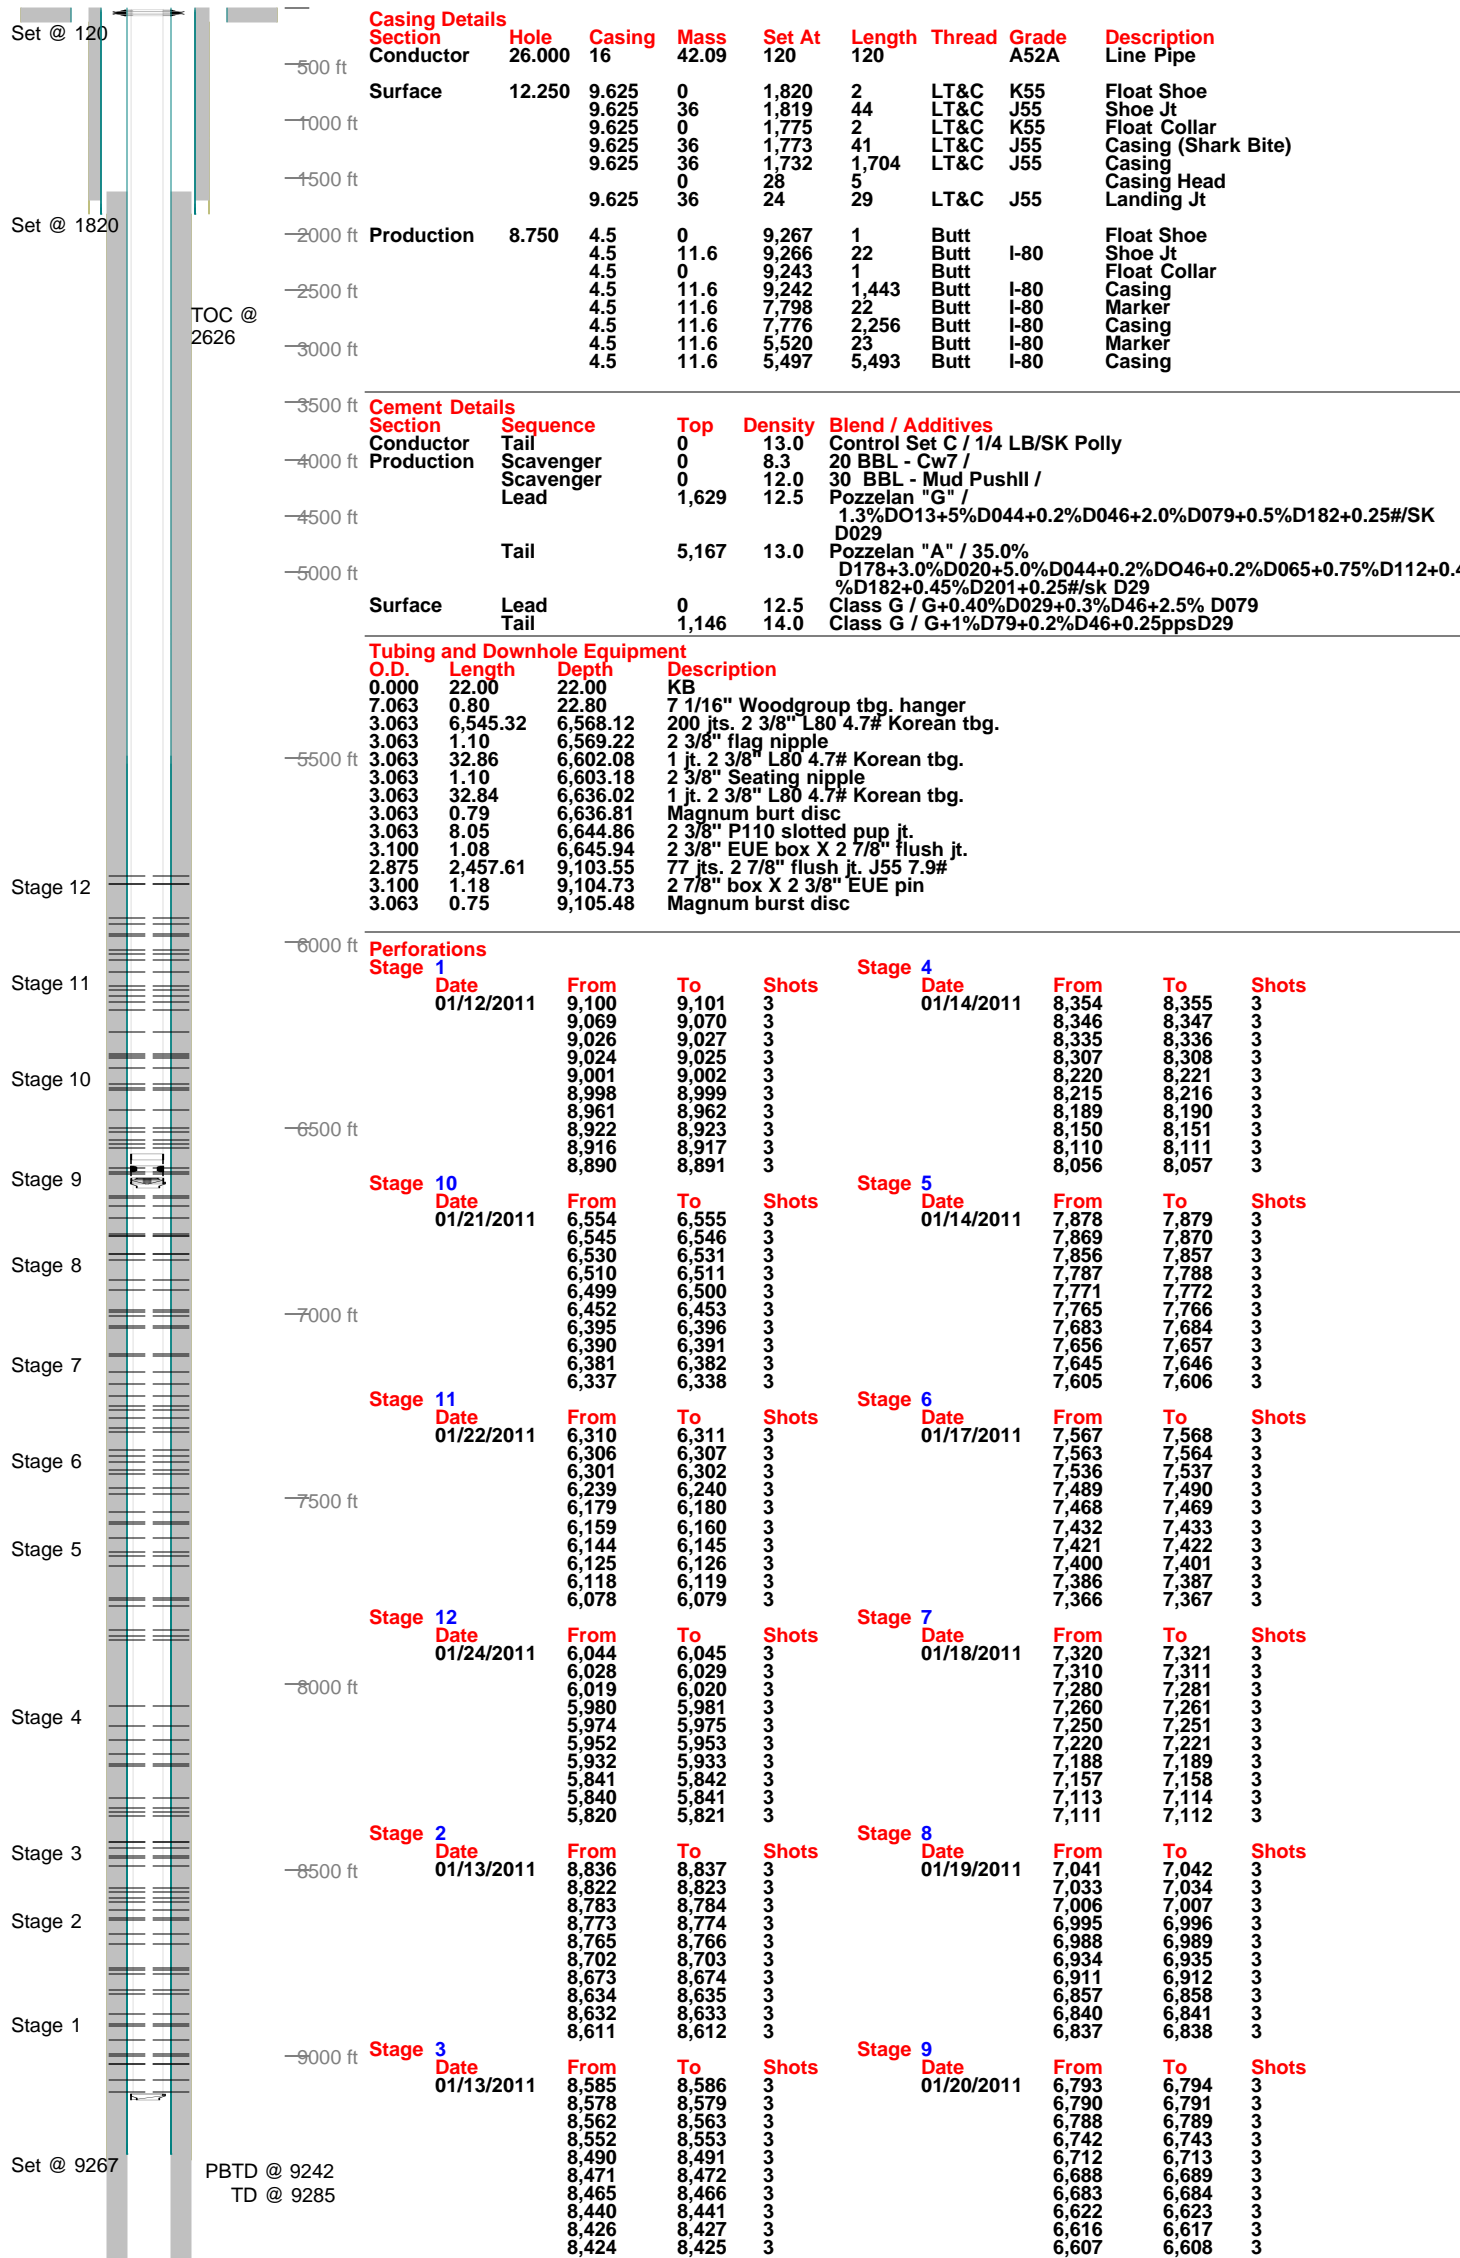

Stage 1	: 8,890 - 9,101, 30 - 0.420"	shots, 2186 bbls of Slickwater	Report Date: 01/13/2011
Stage 2	: 8,611 - 8,837, 30 - 0.420"	shots, 6772 bbls of Slickwater	Report Date: 01/13/2011
Stage 3	: 8,424 - 8,586, 30 - 0.420"	shots, 7608 bbls of Slickwater	Report Date: 01/14/2011
Stage 4	: 8,056 - 8,355, 30 - 0.420"	shots, 9803 bbls of Slickwater	Report Date: 01/14/2011
Stage 5	: 7,605 - 7,879, 30 - 0.420"	shots, 11431 bbls of Slickwater	Report Date: 01/17/2011
Stage 6	: 7,366 - 7,568, 30 - 0.420"	shots, 8457 bbls of Slickwater	Report Date: 01/18/2011