
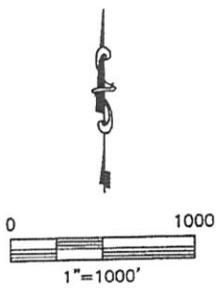


WELL LOCATION CERTIFICATE

SECTION: 25
TOWNSHIP: 4N
RANGE: 65W

THIS MAP DOES NOT REPRESENT A BOUNDARY SURVEY

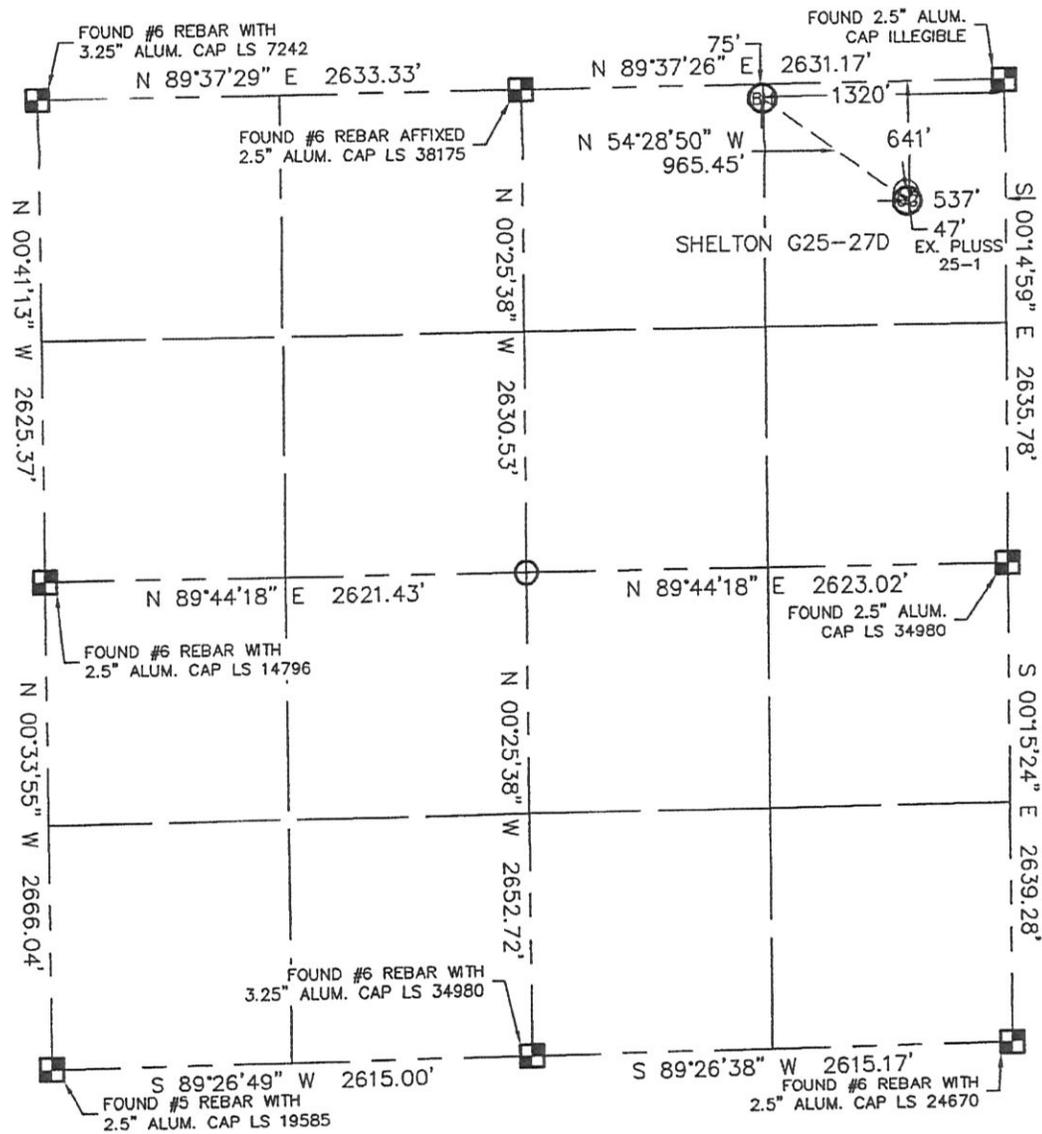

In accordance with a request from Beau Fritz with Noble Energy Inc. Lat40°, LLC has determined the surface location of the SHELTON G25-27D to be 641' from the NORTH line and 537' from the EAST line and the bottom hole to be 75' from the NORTH line and 1320' from the EAST line as measured at right angles from the section lines of Section 25, Township 4 North, Range 65 West of the Sixth Principal Meridian, County of Weld, State of Colorado.


I hereby state that this Well Location Certificate was prepared by me, or under my direct supervision, that the fieldwork was completed on 12/17/10, for and on behalf of Noble Energy Inc. That this is not a Land Survey Plat or an Improvement Survey Plat, and that it is not to be relied upon for establishment of fence, building, or other future improvement lines.

NOTE:

- 1) Bearings shown are Grid Bearings of the Colorado State Plane Coordinate System, North Zone, North American Datum 1983/2007. The lineal dimensions as contained herein are based upon the "U.S. Survey Foot."
- 2) Ground elevations are based on an observed GPS elevation (NAVD 1988 DATUM).
- 3) NEAREST EXISTING WELL: PLUSS 25-1 47'
- 4) IMPROVEMENTS: See LOCATION DRAWING for all visible improvements within 400' of disturbed area.
- 5) SURFACE USE: RANGELAND
- 6) INSTRUMENT OPERATOR: BRIAN BRINKMAN

SURFACE LOCATION
LATITUDE: 40.28869°N
LONGITUDE: 104.60418°W
PDOP: 1.6
ELEV: 4828
1/4,1/4: NE1/4NE1/4
NEAREST PROPERTY LINE: 537' EAST

BOTTOM HOLE
LATITUDE: 40.29025°N
LONGITUDE: 104.60698°W

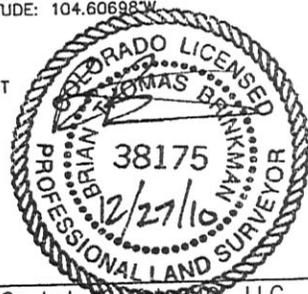

NOTE
According to Colorado law, you must commence any legal action based upon any defect in this W.L.C. within three years after you discover such defect. In no event, may any action based upon any defect in this survey be commenced more than ten years after the date of the certificate shown hereon. (13-80-105 C.R.S.)


LEGEND

-  = ALIQUOT MONUMENT AS DESCRIBED
-  = CALCULATED POSITION

Brian T. Brinkman—On behalf of Lat40°, LLC
Colorado Licensed Professional
Land Surveyor No. 38175 PROJECT#: 2010153

SITE SKETCH
SHELTON G25-27D

SECTION: 25
TOWNSHIP: 4N
RANGE: 65W

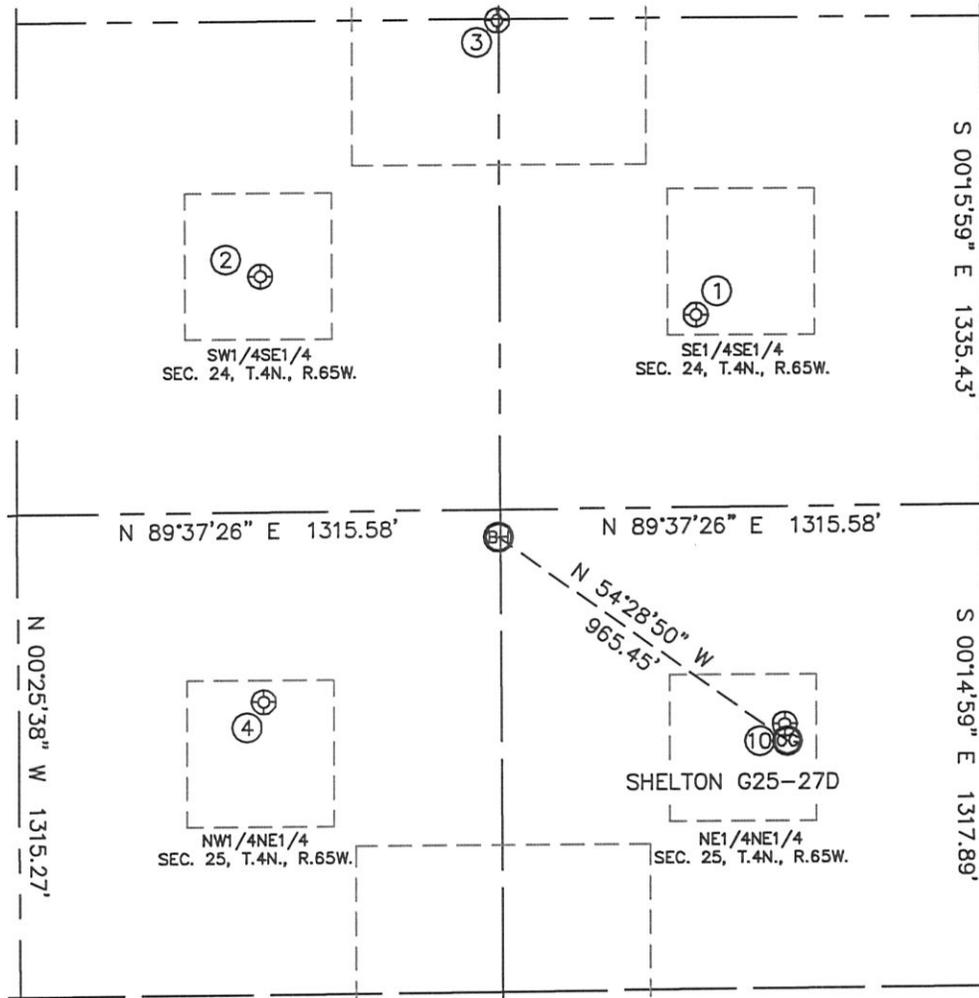

①
BURKE RG 24-16
SE1/4SE1/4
525' FSL
780' FEL
LAT-40.29189°N
LONG-104.60503°W
PDOP: 1.8
ELEV: 4834

②
BURKE 24-2
SW1/4SE1/4
643' FSL
1965' FEL
LAT-40.29223°N
LONG-104.60927°W
PDOP: 1.7
ELEV: 4808

③
BROOMFIELD 24-45
SW1/4SE1/4
1336' FSL
1317' FEL
LAT-40.29412°N
LONG-104.60694°W
PDOP: 3.1
ELEV: 4816

④
SHELTON G25-02
NW1/4NE1/4
517' FNL
1962' FEL
LAT-40.28904°N
LONG-104.60929°W
PDOP: 2.2
ELEV: 4804

⑩
PLUSS 25-1
NE1/4NE1/4
594' FNL
543' FEL
LAT-40.28882°N
LONG-104.60421°W
PDOP: 1.5
ELEV: 4827

