




Lease Name: SRC 31-5D

Legals: SWSE – Sec. 32, T6N, R66W

County: Weld County, Colorado

API#: 05-123-30075-00

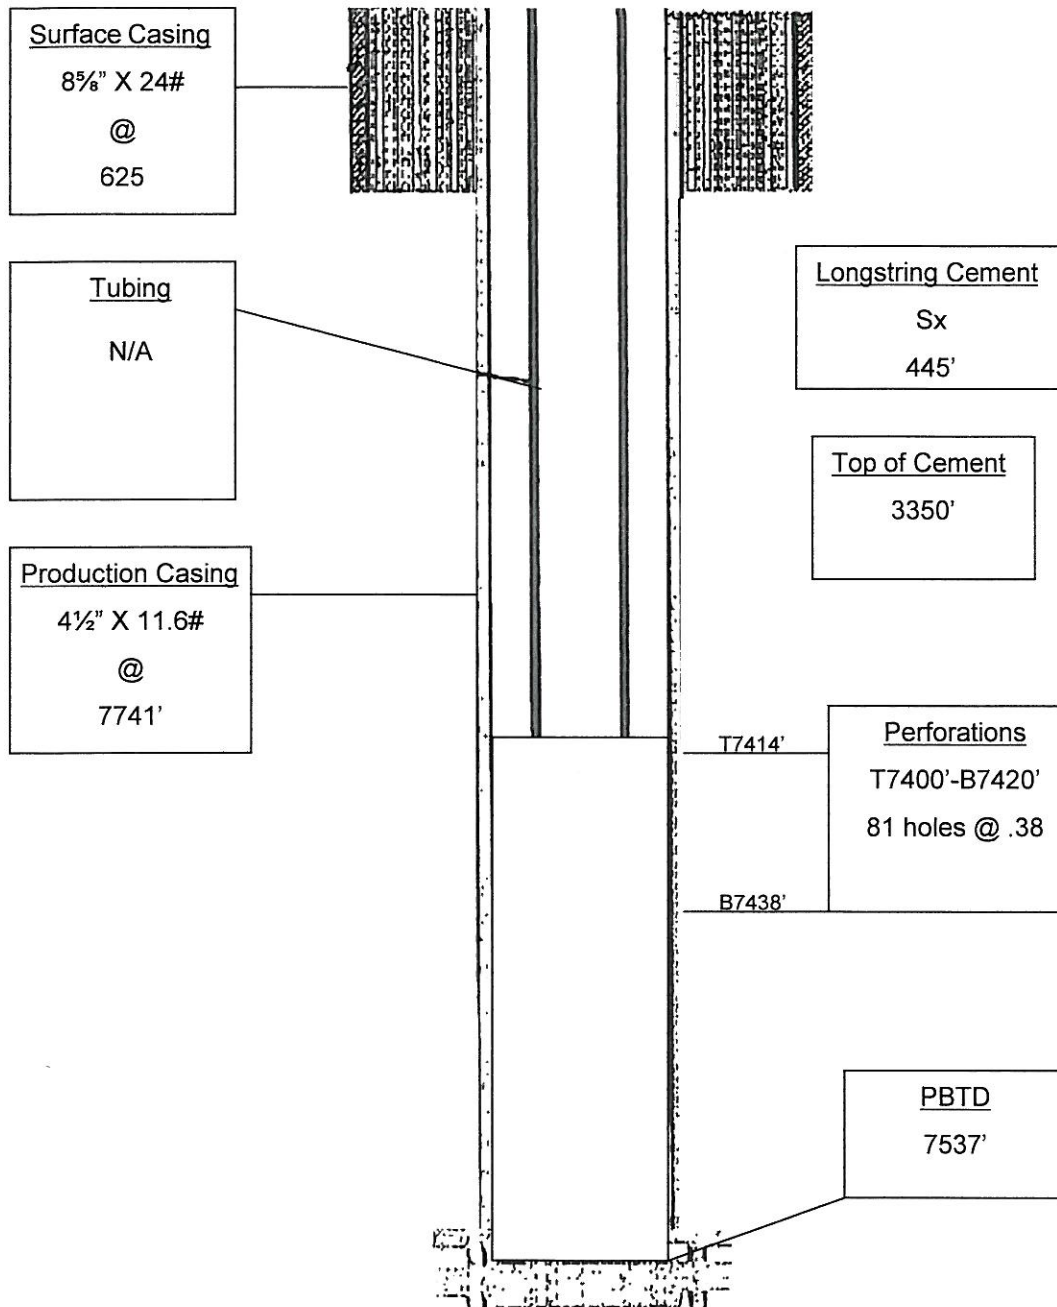

Wellbore Diagram