



PLS Group, LLC
 109 Coronado Ct. - Bldg. 7
 Fort Collins, Colorado 80525

WELL LOCATION CERTIFICATE

THIS MAP DOES NOT
 REPRESENT A BOUNDARY SURVEY

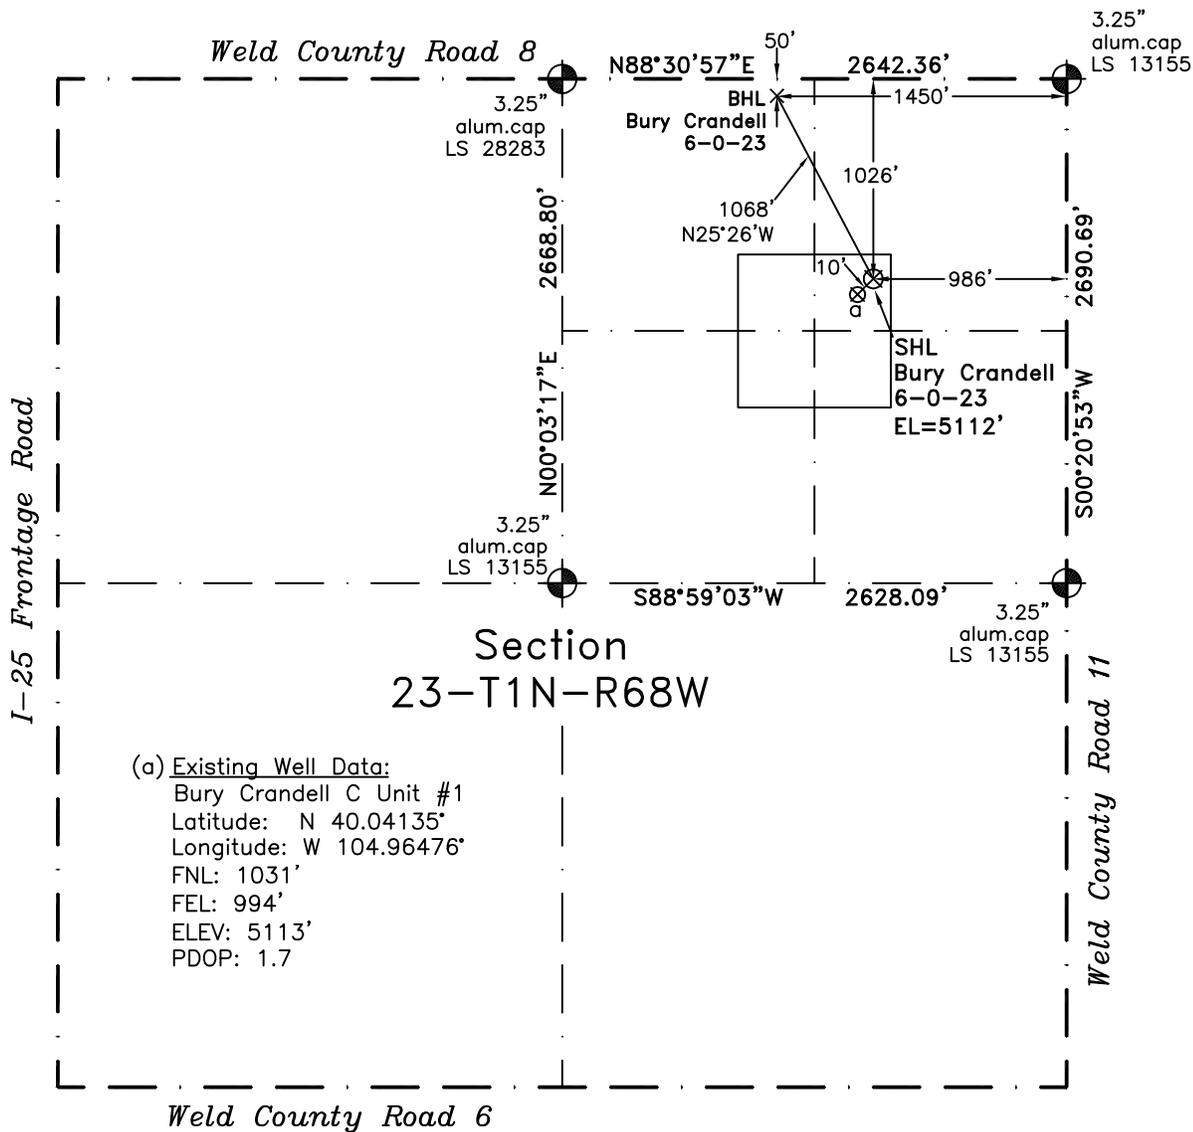

(a) Existing Well Data:
 Bury Crandell C Unit #1
 Latitude: N 40.04135°
 Longitude: W 104.96476°
 FNL: 1031'
 FEL: 994'
 ELEV: 5113'
 PDOP: 1.7

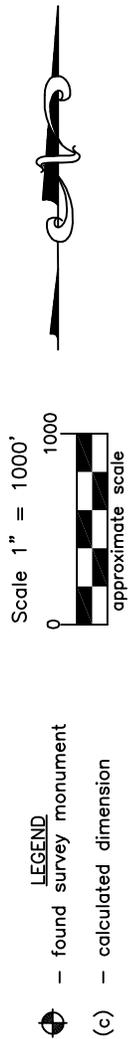

LEGEND
 — found survey monument
 (c) — calculated dimension

In accordance with a request from Jack Croom of EnCana Oil & Gas (USA) Inc., Frederick Land Surveying, Inc. has determined the location of the **Bury Crandell 6-0-23** well site to be SHL: 1026' FNL and 986' FEL, (BHL: 50' FNL and 1450' FEL) as measured at ninety (90) degrees from the section lines of Section 23, Township 1 North, Range 68 West, 6th Principal Meridian, City and County of Broomfield, CO.

Proposed Surface Hole Data:
 Latitude: N 40.04136° (BHL 40.04402°)
 Longitude: W 104.96473° (BHL 104.96635°)
 PDOP: 1.2

Nearest: Building 1227' northwest Above Ground Utility 930' east
 Public Road 976' east Railroad 398' northeast
 Property Line 986' east Well Window: SHL is 67' inside
 Existing Well: Bury Crandell C Unit #1 10' southwest

- Notes:
- 1) Bearings and distances based on NAD 83 Colorado North State Plane Coordinates using RTK GPS observations taken 3/31/11 by operator J.R. McGehee.
 - 2) Conversion factor to ground (1.000280465).
 - 3) Elevations based on NAVD 88 GPS heights and Geoid 2003 corrections.
 - 4) See improvement map for visible improvements within 400 feet of pad site.
 - 5) The surface use is agricultural field.

I hereby certify that this Well Location Certificate was prepared by me or under my direct supervision on 3/31/11 for and on behalf of EnCana Oil & Gas (USA) Inc. That it is not a Land Survey Plat or an Improvement Survey Plat and that it is not to be relied upon for establishment of fences, buildings, or other future improvement lines.

John Robert McGehee LS#38219
 Well: Bury Crandell 6-0-23 WLC

NOTICE: According to Colorado law you must commence any legal action based upon any defect in this W.L.C. within three years after you first discover such defect. In no event may any action based upon any defect in this W.L.C. be commenced more than ten years from this said date of the certification shown hereon.