


T6N R81W Sec 24

## State 6-81-24-4 Location Map

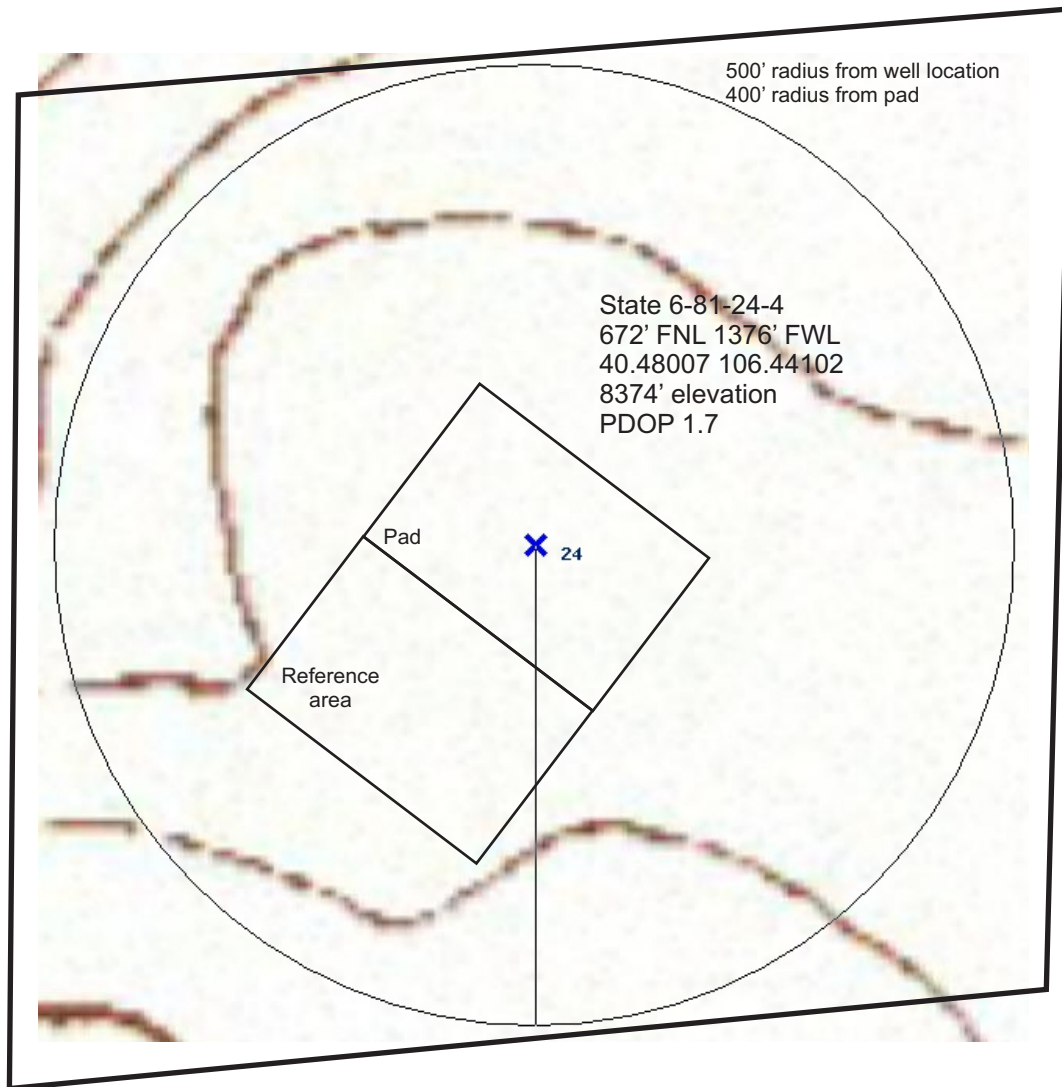

Power lines are 645' east-southeast of the location.  
Hwy 14 is 815' W of location.