



WELL: Puckett 12B-36D
FIELD: Grand Valley
COUNTY: Garfield
STATE: Co.

DATE JOB COMPLETED: 04/17/2011

ELEVATION KB: 8393'

HOLE SIZE: 16"

TOOL TYPE:

TYPE FLOAT COLLAR: Top-Co

TYPE FLOAT SHOE: Top-Co

TYPE CEMENT BASKET:

OTHER:

045-19808

RECEIVED


APR 18 2011

COGCC

JT ABOVE KB#:

TOP JOINT #:

SIZE	WEIGHT	MAKE	API GRADE	THREAD	COUPLINGS	NO JOINTS	LENGTH
9 5/8"	36#	Evraz	J-55	8rd	LTC	49	2165
1 1/2"	2.76#	Lakeside	J-55	10rd	IJ	62	2070
TOTALS:							

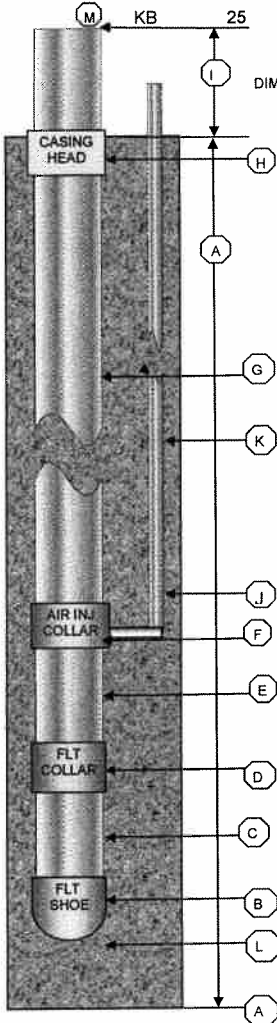

TUBULAR DATA

JTS. RACK TALLY (THDS OFF)	2165	
JTS CSG LEFT ON RACK (THDS OFF)	0	(-)
LANDING JOINT	25	(+)
CSG USED INCLUDING LDJT (THDS OFF)	2190	(=)
FEET OF LDJT REMOVED	25	(-)
CASING LEFT IN HOLE JOINTS	2165	(=)
AIR INJECTION COLLAR	2	(+)
FLOAT COLLAR	1.5	(+)
FLOAT /GUIDE SHOE	1.5	(+)
OTHER	6	(+)
CASING IN HOLE	2176	(=)
KB TO TOP OF CASNG OR CASING HEAD	25	(+)
TOTAL DEPTH OF CASING POINT	2201	(=)

CEMENT DATA

CENTRALIZER LOCATIONS:

CEMENT BASKETS:

CEMENT COMPANY: BJ Services.

TYPE CEMENT: FIRST STAGE: 1317 sksTypeIII

TYPE CEMENT: SECOND STAGE: 194 sksTypeIII

ADDITIVES: FIRST STAGE: 35.65 Poz.04lbs/skstaticfree+ 5%C.C.+ 25lbs/cello flake+2lb/skol seal+ 5% Sodium Met.+ 5gals.skfp.

ADDITIVES: SECOND STAGE: .04lbs/skStaticFree+1%C.C.= + 25% Cello Flake+ 5gals/skfp-13+65.2% fresh water.

SLURRY WEIGHT: 12.4/14. PPG: YIELD 1.97/1.47 CU. FT/ SK

TOTAL SK CEMENT: 1511 sks.

PLUG DOWN TIME: 4:15AM RETURNS AT PLUG DOWN: None %

MIX WATER: 366/164 Bls

MUD WEIGHT: 8.8 SECS

MIXED CEMENT AT: 6.1 PSIG

DISPLACED CEMENT AT: 4.8/2.2 144/440 PSIG

PLUG DOWN WITH: 2.2 1094 PSIG

CHECKED FLOAT: yes Held ?

TOP OF CEMENT BEHIND CASNG (CALCULATED): Surface

TOP OF CEMENT CALCULATED USING: To-Out to surface

PRECEDED CEMENT WITH: Rubber Latch down plug

DISPLACED CEMENT WITH: Water.

LINES TETED TO: 3500 Psi.

CASING PICK UP (PRIOR TO CEMENTING): 110,000

CASING SLACK OFF (PRIOR TO CEMENTING): 80,000

RIG RELEASED DATE AND TIME:

SUPERVISOR: Gene sandefer

Slurry 512 bbls. Pumped 20 bbls. Sugar water down parasite before cementing and 20 bbls sugar water down parasite after cementing all good.

Type III with add. Top-Out 365 bbls. Slurry 1130sks. 14.2# 1.47 yield.