High Prairie Survey Co.

Physical Address: 401 Arapahoe St.
Mail to: Box 384 Kiowa, CO 80117
Ph. 303-621-8672 - Fax 303-621-2717
www.highprairiesurvey.com

Job: 10061 Kerry #6 Inv # 1440

High Prairie Surveying of Kiowa, Colorado has in accordance with a request from **Jack Fincham, Wiepking Fullerton Energy** has determined the location of **Kerry #6** to be **1980 feet FNL**, and **1980 feet FEL**, (90° off Section lines) **of** SECTION **20**, Township **10s**, Range **55w** of the 6th Principal Meridian, **Lincoln County,** Colorado.

Date: Staked on 3-04-11 drawn on 3-07-10.

Re: Staked by Keith Westfall
Drawn: Drawn by Elijah Frane

Basis of Elevation Spot: USGS BM = E 25, PID = KJ0219, H-Order = First, V-Order = First, Stability = C, P-DOP = 3.10, Sats = 9, US NAD 83 CO-C, Lat. = 39.21461, Long. = W103.60209, Elevation = 5248.17 gr. (us FT)

Notes: There are no apparent improvements within 400 ft of proposed well pad.
The ground elevation at staked location = 5191.90' gr.
This drawing does not represent a monumented survey or Land Survey Plat.
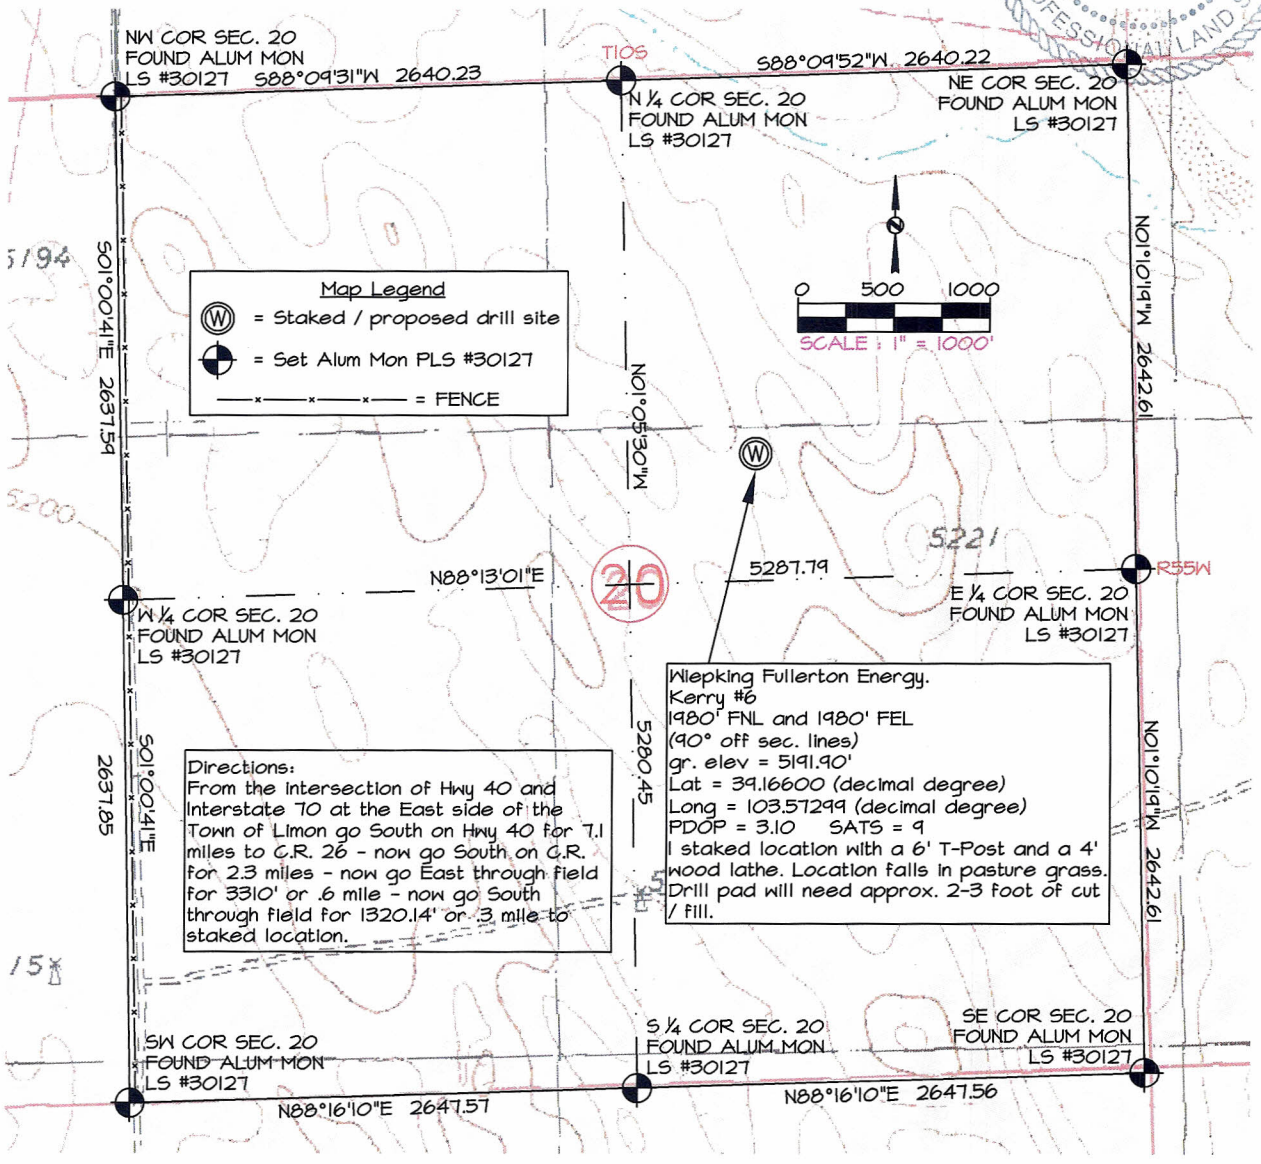
Basis of Bearing: Bearings were determined based on the West line of Section 20 to bear S 01°00'41" E with all other bearings contained herein relative thereto.