


Shasta 24-8  
(Rancho Escondido Subdivision)

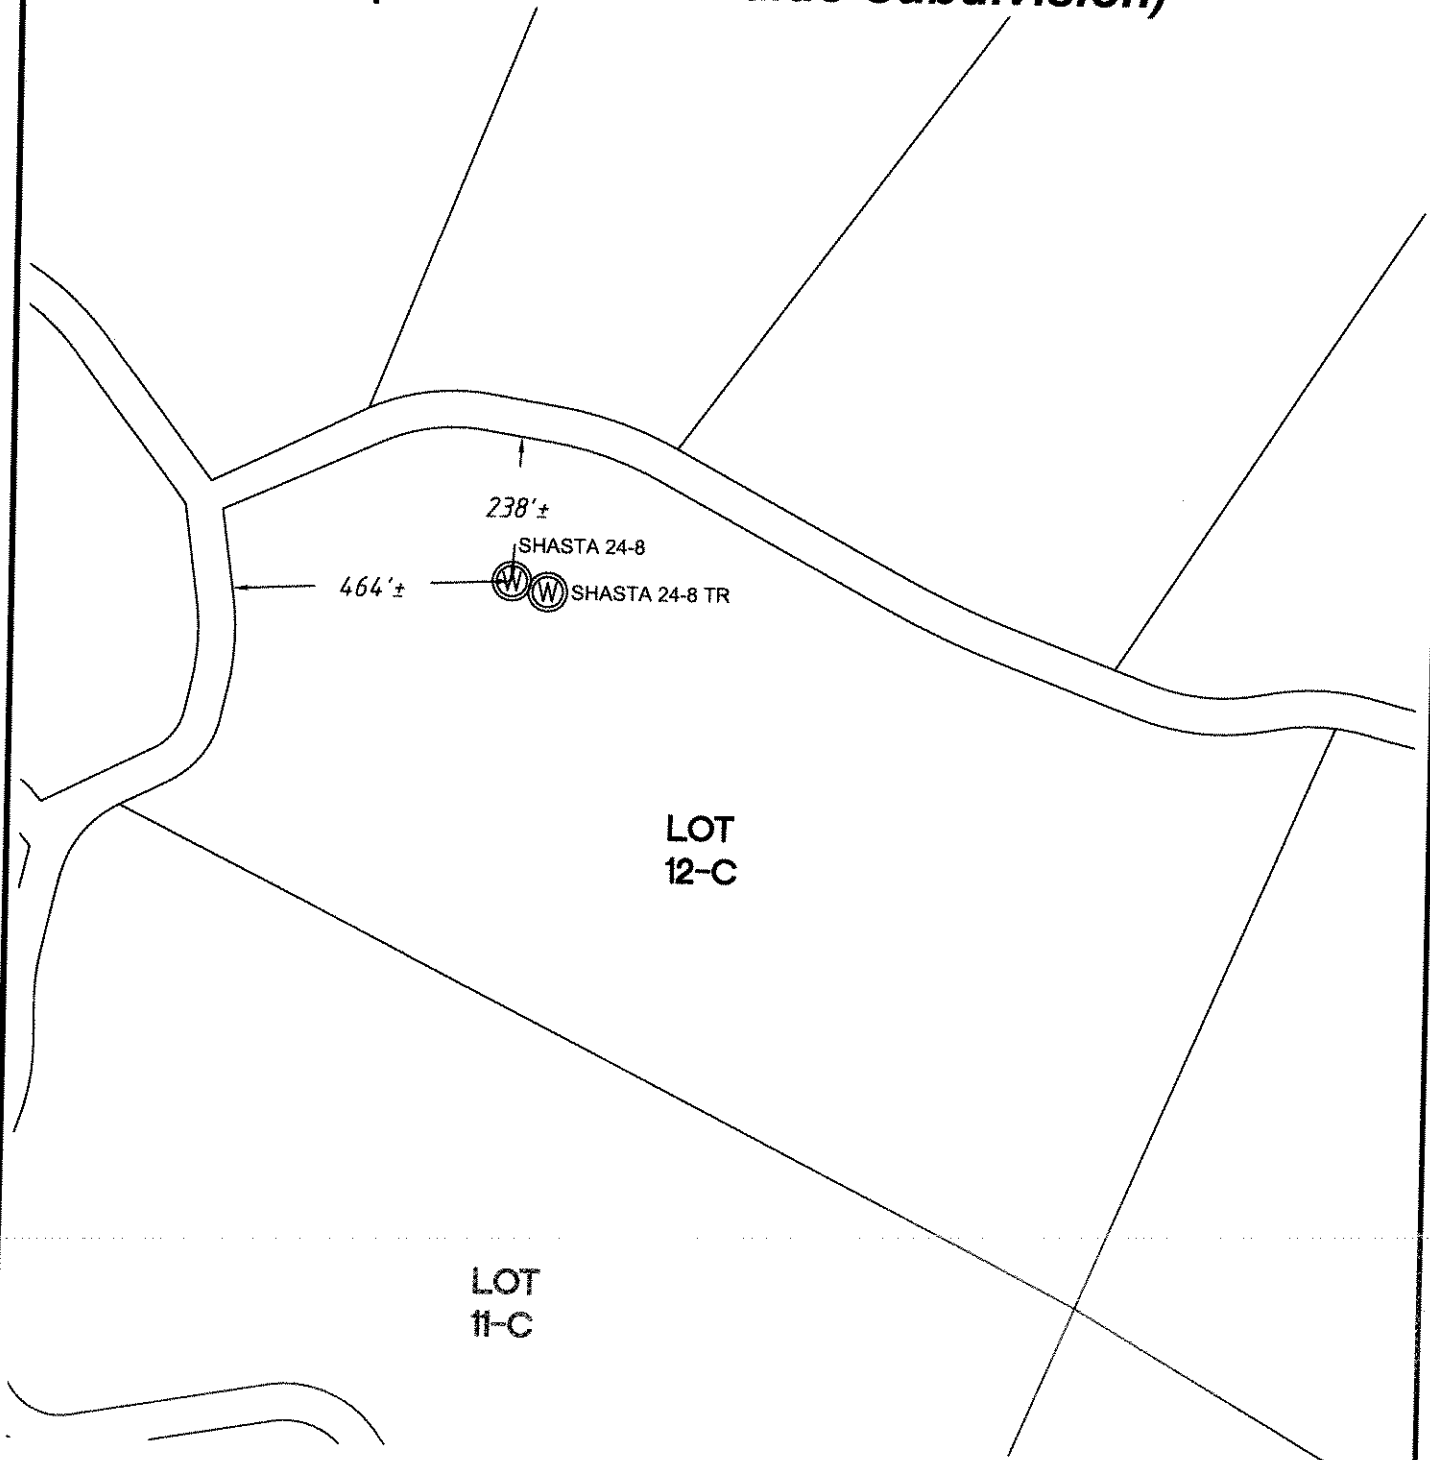

**NOTE:**

FOOTAGES GIVEN ARE ONLY ESTIMATES BASED ON SUBDIVISION PLATS AND TIED TO EXISTING CONTROL. A FULL BOUNDARY SURVEY IS REQUIRED TO DETERMINE TRUE SUBDIVISION LOT AND ROAD LOCATIONS, DISTANCES AND AREA OR FOOTAGE CALCULATIONS.

DATE: November 09, 2010

**GRAPHIC SCALE**



**SHIELDS SURVEY Ltd. Co.**  
Raton, New Mexico 87740  
(575)445-1232