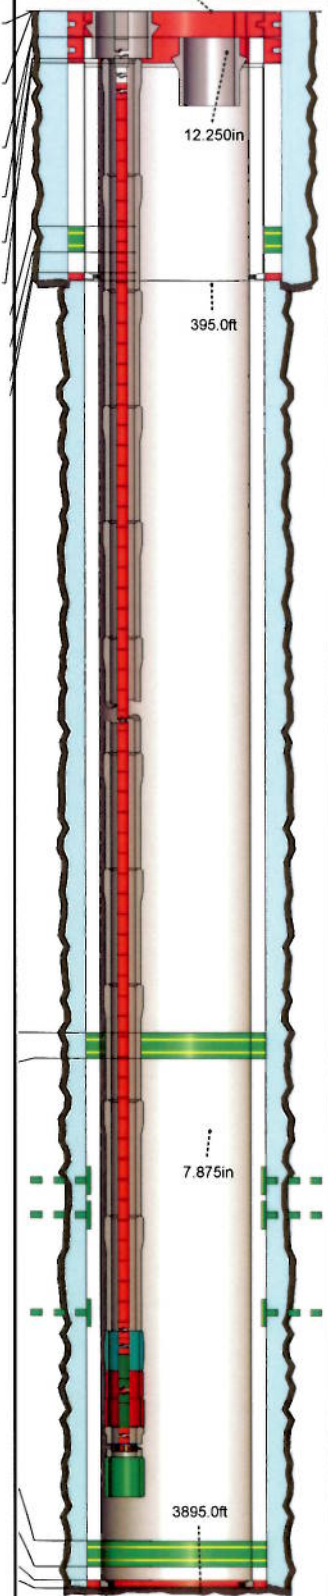


SPANISH FORK GAS UNIT A 4
NORTH AMERICA - NORTH AMERICA GAS - BP

Region: NORTH AMERICA	Event: WORKOVER	Wellbore #: OH	Datum Elevation: 6,521.0ft
Bus Unit: NORTH AMERICA GAS	Start Date: 2/14/2011	Top TMD: 16.0ft	Ground Level: 6,505.0ft
Perf Unit: WEST	End Date: 2/15/2011	Bottom TMD: 3,895.0ft	Datum: RKB
Field: IGNACIO BLANCO	Objective: ROD PUMP INSTALL	Spud: 12/18/2009 15:45	Report Date: 2/15/2011
Asset: SAN JUAN	State/Prov: COLORADO	API No.: 0506709674	Slot No.:

Casing Details	Casing Depths	Wellsketch (2/15/2011)	Equip Depth	Equip. Details	Perforations	STIM	DST	TES	CORE	SW	LOG	Hole Depths	Lithology
CASING PUPJOINT 8.625 in, J-55, 24	16.0ft		16.0ft	POLISHED ROD 1.25 in,								16.0ft	
CASING PUPJOINT 5.5 in, L-80	16.0ft		16.0ft	2-7/8" EUE 8RD X 7" OD HANGER									
CASING PUPJOINT 8.63 in, J-55, 24	17.4ft		42.0ft	ROD 1 in, D									
CASING JOINTS 5.5 in, J-55, 15.5	17.1ft		16.5ft	TUBING HANGER 7.063 in, N-80									
CASING JOINTS 5.5 in, J-55, 15.5	19.5ft		67.0ft	PONY ROD 1 in,									
CASING JOINTS 8.625 in, J-55, 24	22.5ft		17.2ft										
FLOAT COLLAR 8.625 in, K-55, 24	338.6ft											395.0ft	
CASING JOINTS 8.625 in, J-55, 24	339.4ft											395.0ft	
FLOAT SHOE 8.625 in, K-55, 24	380.7ft												
	382.1ft												
			16.9ft	2-7/8" EUEU 8RD P-110									FRUITLAND COAL
			71.0ft	6.5# TUBING SRL T&C									
				COIL TUBING 1 in,									
MARKER JOINT 5.5 in, J-55, 15.5	3050.6ft												
CASING JOINTS 5.5 in, J-55, 15.5	3060.6ft												
FLOAT COLLAR 5.5 in, L-80	3841.0ft		3669.0ft	PONY 1" X 4' FT									
CASING JOINTS 5.5 in, J-55, 15.5	3841.9ft		3673.0ft	SHEAR TOOL 1 in,									
FLOAT SHOE 5.5 in, L-80	3883.0ft		3695.1ft	2-7/8" EUEU 8RD F-NNIPPLE 2.28 ID									
	3884.2ft		3696.1ft	2-7/8" EUEU 8RD EXPENDIBLE CHECK VALVE									
			3696.9ft	2-7/8" EUE 8RD NIPPLE W/ 1/4" HOLE X 12"									
			3674.0ft	STICK 1" X 25' FT									
			3699.0ft	PONY ROD 1" X 4'									
			3698.0ft	2-7/8" EUE 8RD P-110									
			3703.0ft	6.5# TUBING SRL T&C									
			3730.7ft	PUMP 2 1/2 X 2 X 20"									
			3723.0ft	2-7/8" EUE 8RD									
			3734.2ft										