


Chevron U.S.A. Inc.
 Conductor Depths
SKR-698-09-BV Pad

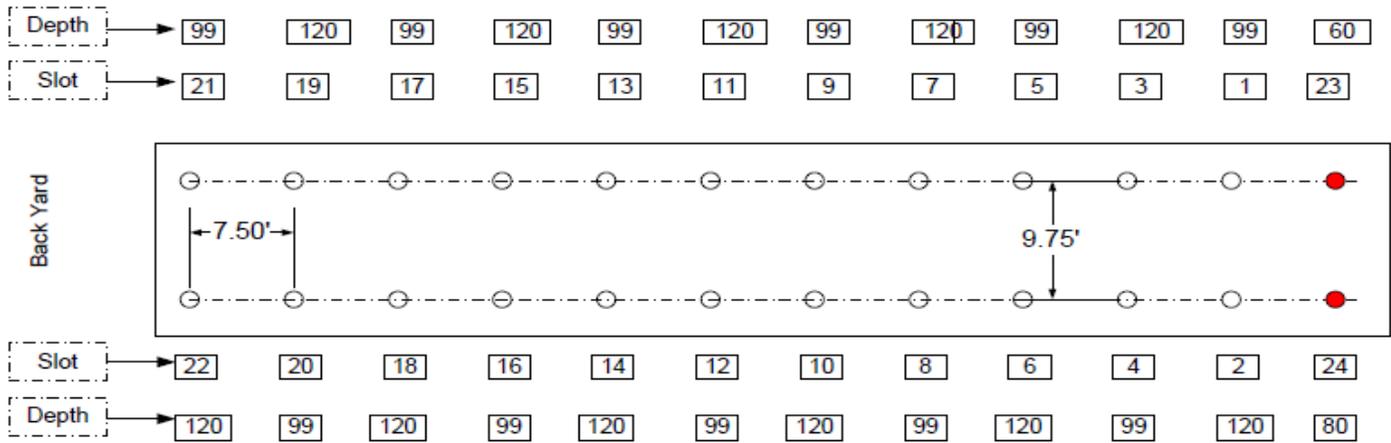

Note: The depths shown are KB depths (measured from 25' above ground surface)