




Lease Name: Meyer #6

Legals: NWNW – Sec. 21, T5N, R66W

County: Weld County, Colorado

API#: 05-123-29166

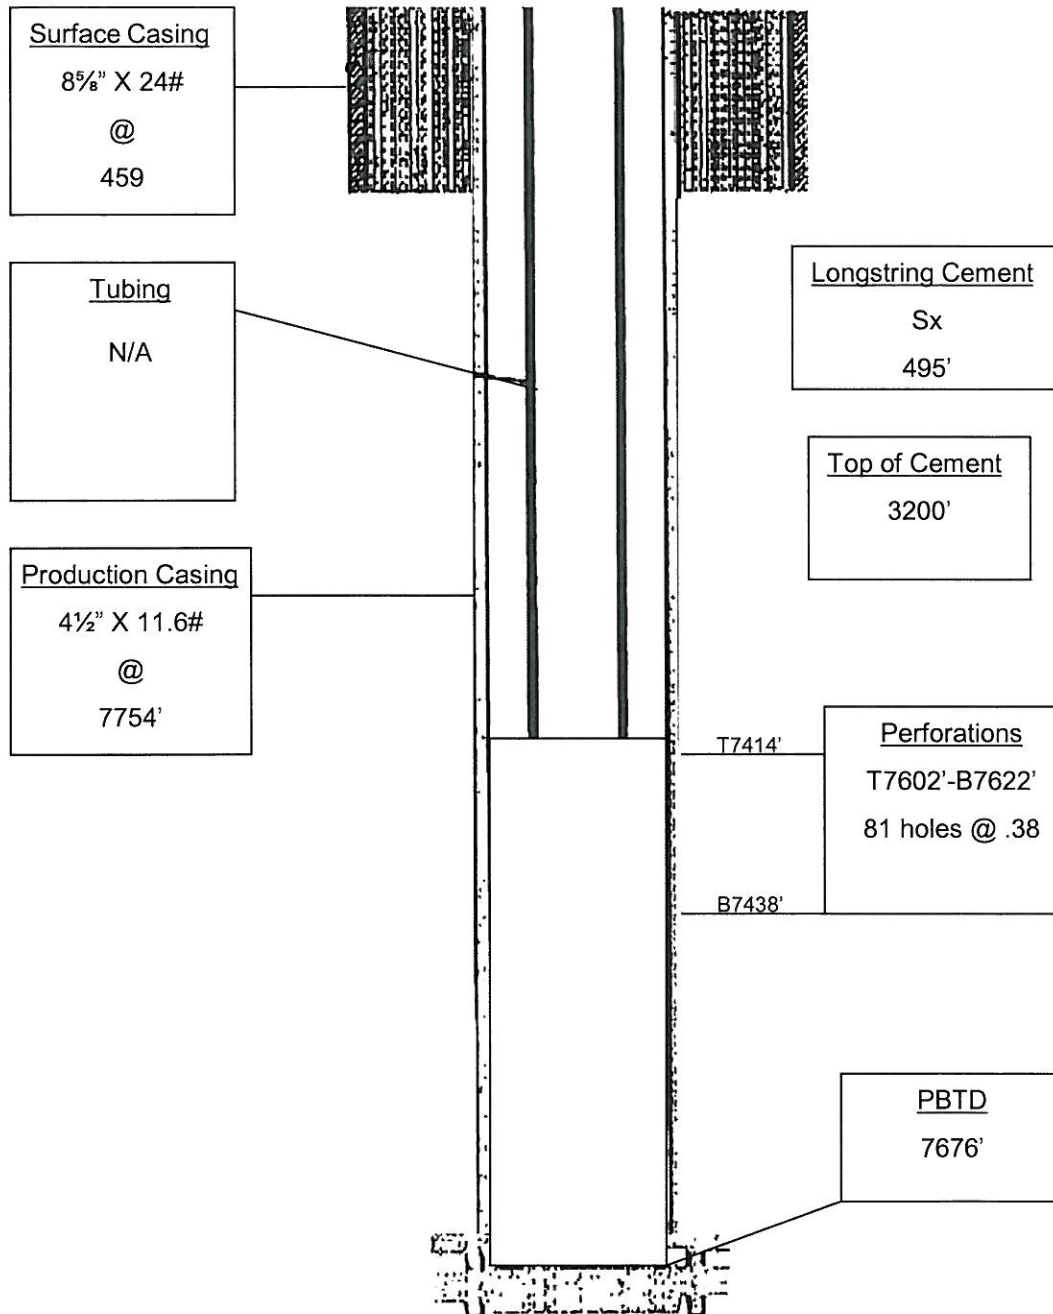

Wellbore Diagram