


LOCATION IS APPROX. 175'
N 46°40'10" E OF AN EXISTING
FENCE LINE

LOCATION IS APPROX. 108.2'
S 87°28'30" W OF AN EXISTING
OVERHEAD POWER LINE

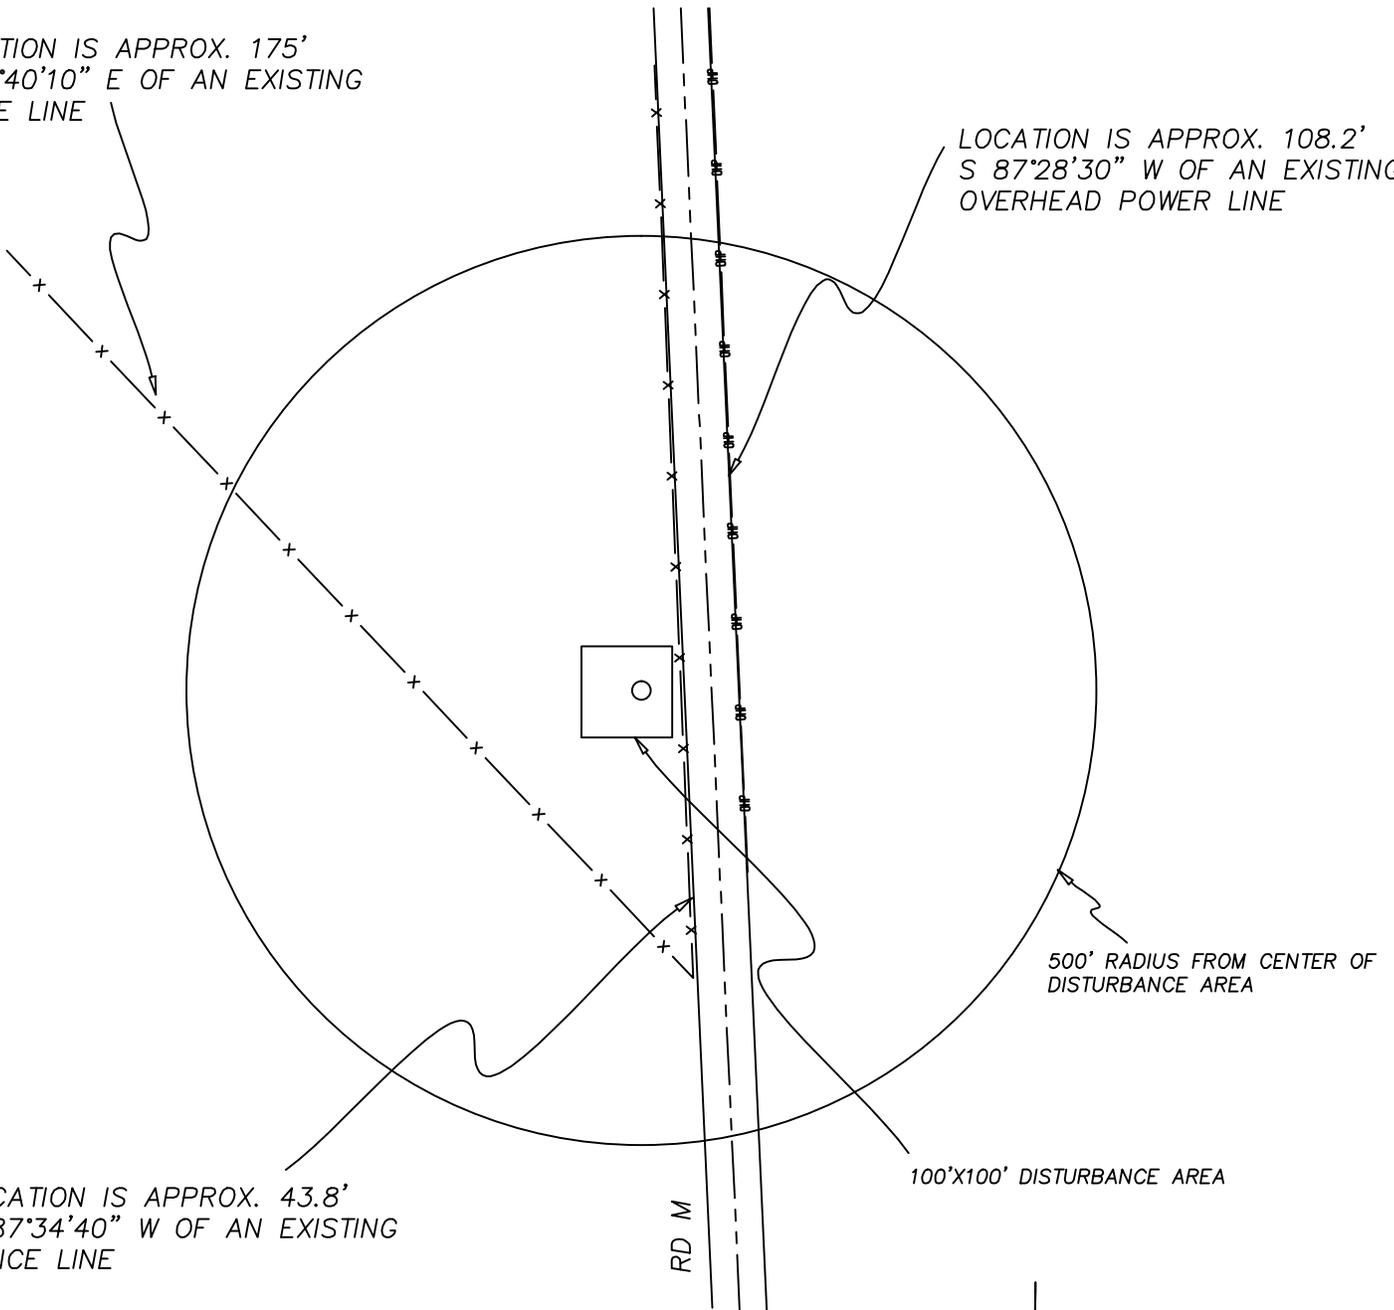


LOCATION IS APPROX. 43.8'
S 87°34'40" W OF AN EXISTING
FENCE LINE

500' RADIUS FROM CENTER OF
DISTURBANCE AREA

100'x100' DISTURBANCE AREA

RD M

- Location
- x — Fence Line
- · - Half-Sec. Line
- - - Section Line
- OP — Overhead Powerline

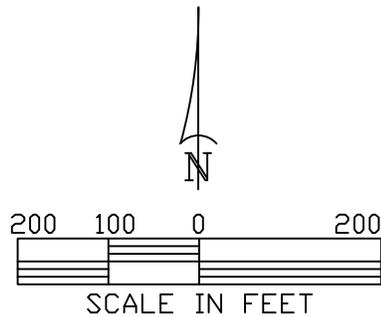



GREAT PLAINS
SURVEYING, INC.

20575 Co. Rd. 21 Phone 970-774-3602
Haxtun, CO 80731 Fax 970-774-3601

LOCATION DRAWING

D BLACH 42-10 1N47W

SCALE 1" = 200'

YUMA COUNTY, COLORADO

L101N47GPS

10401-137