

GREAT WESTERN OIL & GAS COMPANY
Well Name: HCW 24-13
NWSW, Sect. 24, Twp 6N, Rng 67W
Weld County, CO
CURRENT WELLBORE SCHEMATIC as of January 22, 2011


API: 05-123-31500-00

GL Elev: 4757'
 KB Elev: 4773'

Spud: 1/3/2011

Surface Casing :

1/04/2011: 8-5/8" 24# J-55 12 jnts set @ 565'
 Cement w/ 450 sx

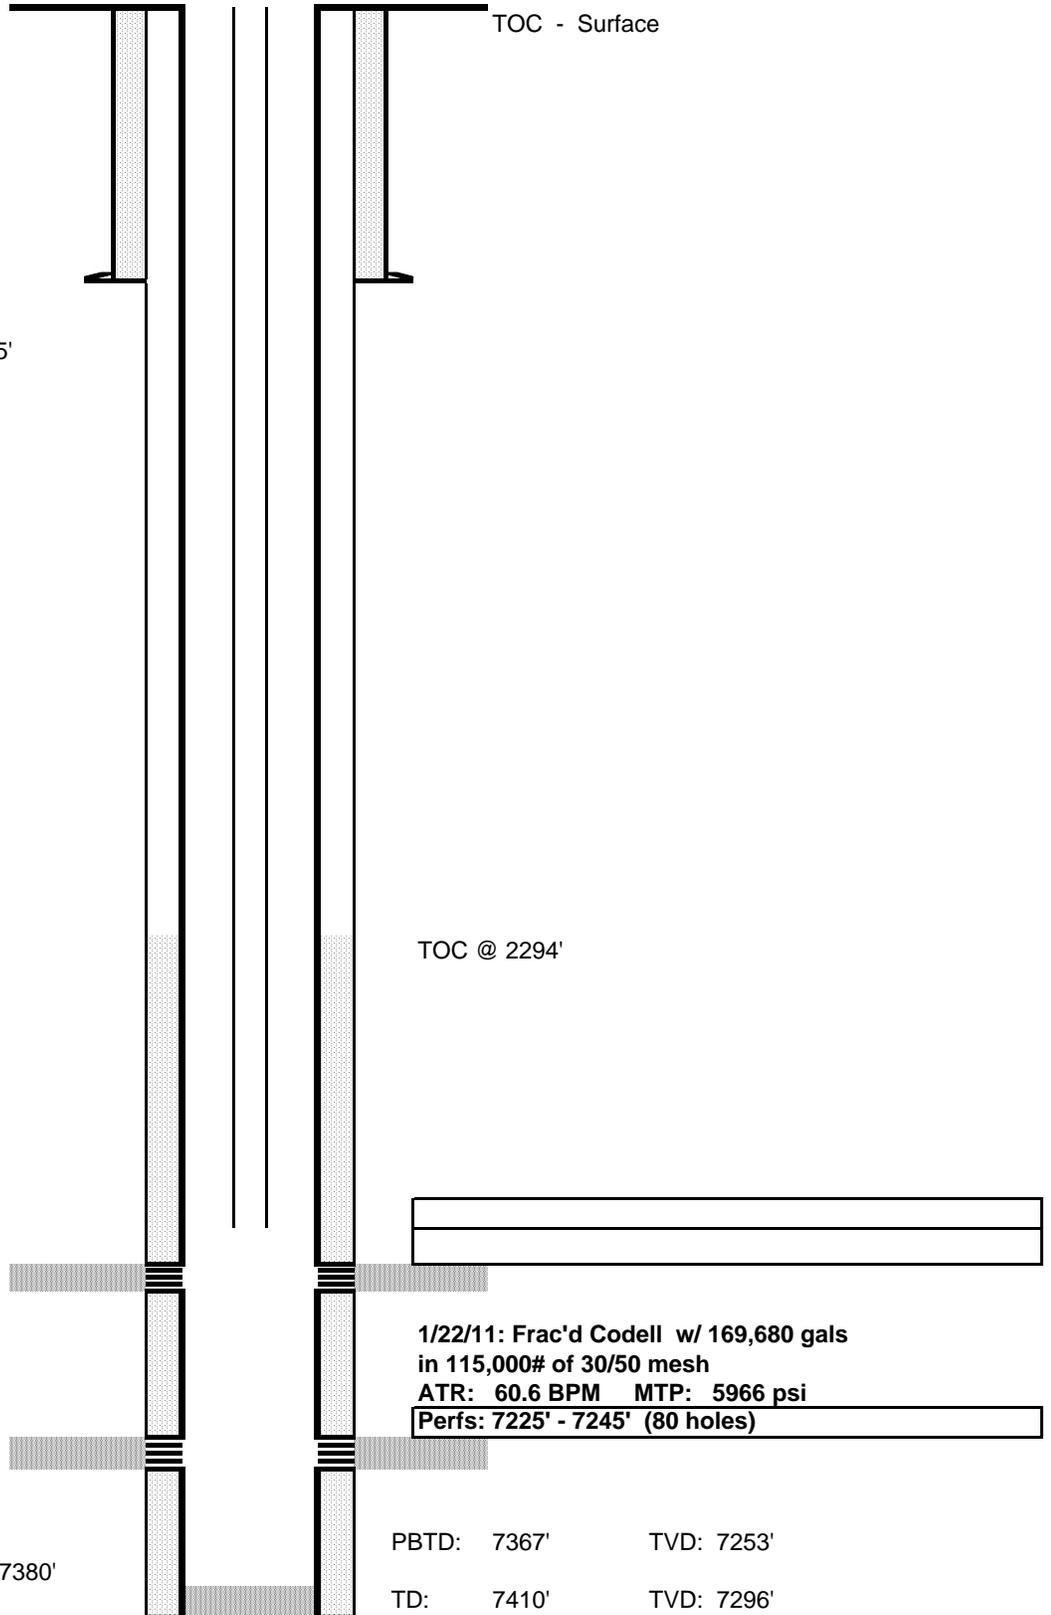

CBP:

Tubing Detail:

Production Casing :

1/09/2011: 4-1/2" 11.6# N80 164 jnts set @ 7380'
 Cement w/ 595 sx

PBTD: 7367' TVD: 7253'

TD: 7410' TVD: 7296'