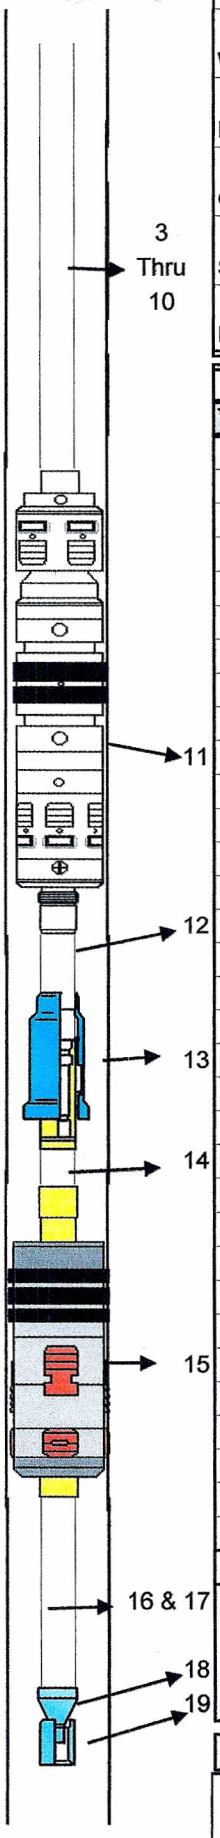

COMPANY:	CHEVRON USA INC.		CASING	LINER	TUBING	TAILPIPE
WELL NUMBER:	U.P. 20-29	SIZE	7"		2 7/8	
FIELD/LEASE:	RWSU	WEIGHT	23#		6.5#	
COUNTY:	Rio Blanco	GRADE	J-55 N-80		J-55	
STATE:	Colorado	THREAD			EUE	
DATE:	19-Jan-11	DEPTH	5757'		5495'	

ITEM	DESCRIPTION	O.D.	I.D.	LENGTH	DEPTH
Well Type:	INJECTION	END OF TAILPIPE →			5682.78
1	KB			13.00	
2	Compression #14,000			-1.50	13.00
3	Pin x Pin 2 7/8" FL Tubing	3.460	2.125	31.74	11.50
4	8' x 2 7/8" Pup Jnt FL	3.668	2.125	8.11	43.24
5	6' x 2 7/8" Pup Jnt FL	3.668	2.125	6.17	51.35
6	6' x 2 7/8" Pup Jnt FL	3.668	2.125	6.12	57.52
7	4' x 2 7/8" Pup Jnt FL	3.668	2.125	4.07	63.64
8	3' x 2 7/8" Pup Jnt FL	3.668	2.125	3.13	67.71
9	2' x 2 7/8" Pup Jnt FL	3.668	2.125	2.32	70.84
10	175 Jnts of 2 7/8" FL Tubing (Double Yellow)	3.668	2.125	5495.09	73.16
11	7" x 2 7/8" PS1-X Premium Packer	6.078	2.401	7.50	5568.25
	RHS-RHR Coated & Carbide Slips				
12	1 Jnt 2 7/8" FGW- FL Tubing	3.868	2.125	31.60	5575.75
13	Polar EXT. 1.875F Slick On/Off Tool 316 S.S.	5.500	1.875	4.50	5607.35
14	6' x 2 7/8" Pup Jnt FGW-PL	3.868	2.401	6.15	5611.85
15	7" x 2 7/8" Loc-Set Packer	6.078	2.401	4.00	5618.00
	RHS-RHR Coated & Carbide Slips				
16	1 Jnt 2 7/8" FGW- PL Tubing	3.868	2.401	29.64	5622.00
17	1 Jnt 2 7/8" FGW- PL Tubing	3.868	2.401	30.29	5651.64
18	2 7/8"Box x 2 3/8"Pin 316 S.S. X-Over	3.668	2.000	0.45	5681.93
19	2 3/8" 316 S.S. Wireline Entry Guide	3.063	2.375	0.40	5682.38
					5682.78

7" 23# J-55 0 TO 5584
7" 23# N-80 5584 TO 5757
OPEN HOLE 5757 TO 6435

Comments:

Prepared For: *MR. Alvin Halcomb*

Prepared b *Andy Key*

MILLER PUMPS / PACKERS
1161 E. 1300 S. VERNAL UT.
435-781 0666