

GREAT WESTERN OIL & GAS COMPANY
Well Name: HCW 24-53
NWSW, Sect. 24, Twp 6N, Rng 67W
Weid County, CO
CURRENT WELLBORE SCHEMATIC as of February 2, 2011

API: 05-123-31501-00

GL Elev: 4757'
KB Elev: 4773'

Spud: 1/10/2011

Surface Casing :


1/11/2011: 8-5/8" 24# J-55 12 jnts set @ 558'
Cement w/ 450 sx

CBP:

Tubing Detail:

Production Casing :

1/15/2011: 4-1/2" 11.6# N80 163 jnts set @ 7284'
Cement w/ 495 sx

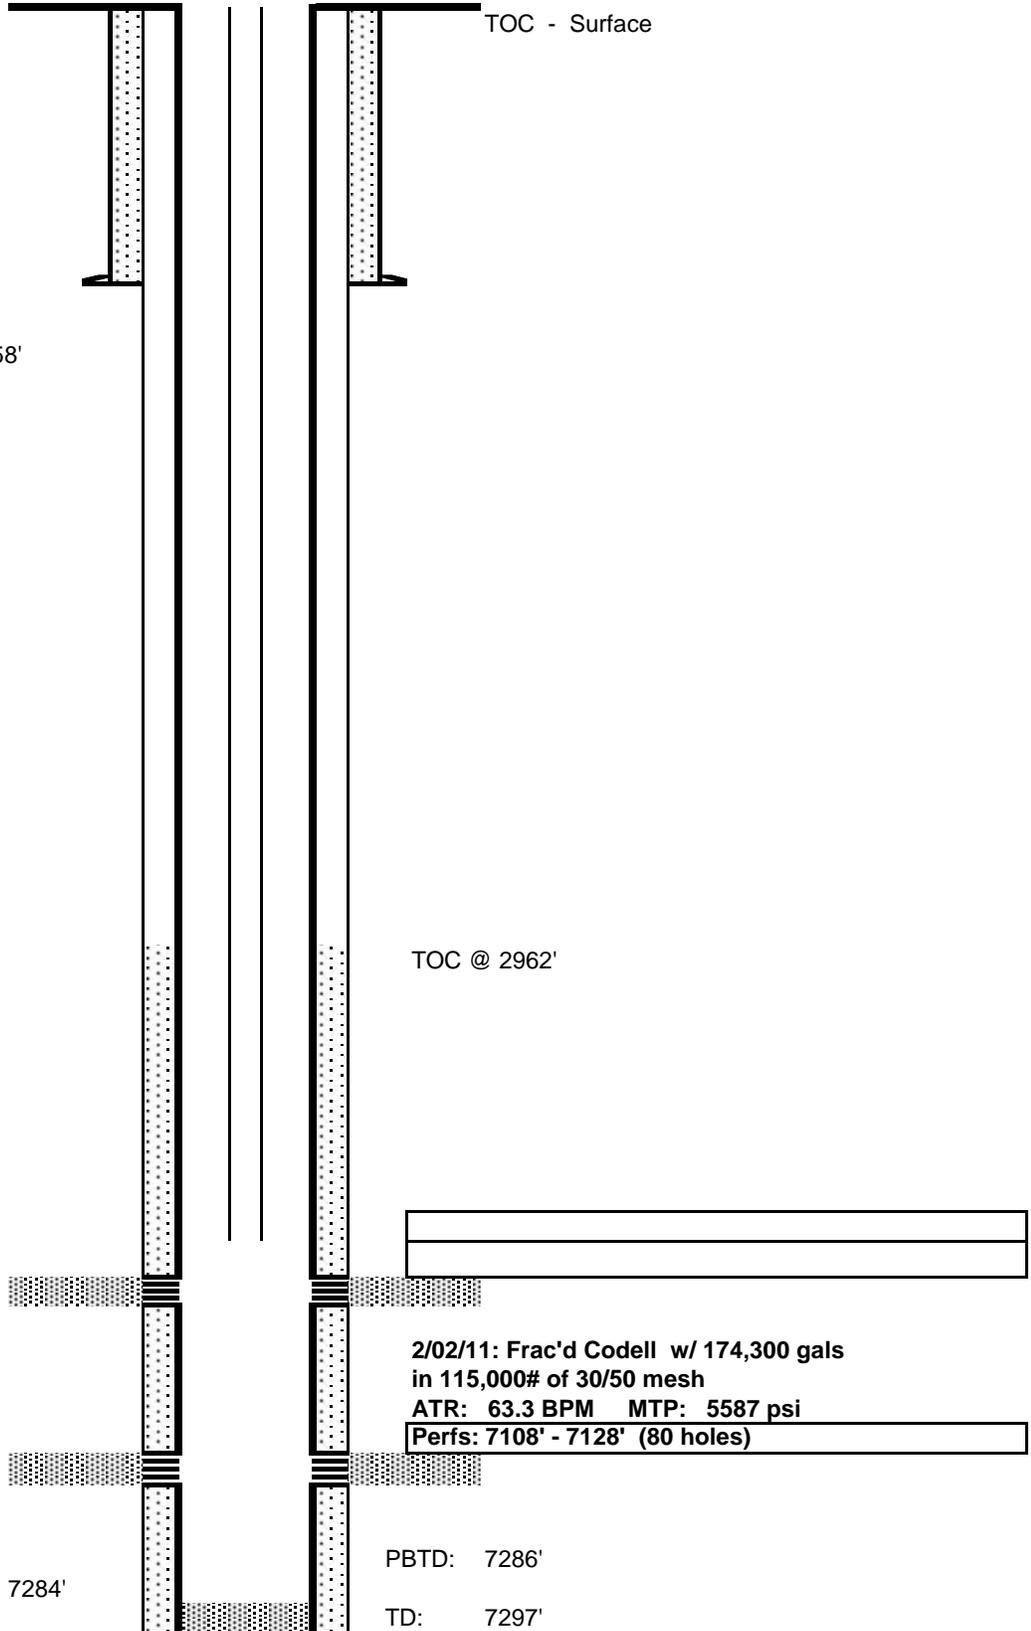

PBTD: 7286'

TD: 7297'

2/02/11: Frac'd Codell w/ 174,300 gals
in 115,000# of 30/50 mesh
ATR: 63.3 BPM MTP: 5587 psi
Perfs: 7108' - 7128' (80 holes)

TOC @ 2962'

TOC - Surface