




Lease Name: SRC TK #21-36D

Legals: NENW –

Sec. 36, T7N, R66W

County: Weld County, Colorado

API#: 05-123-30463

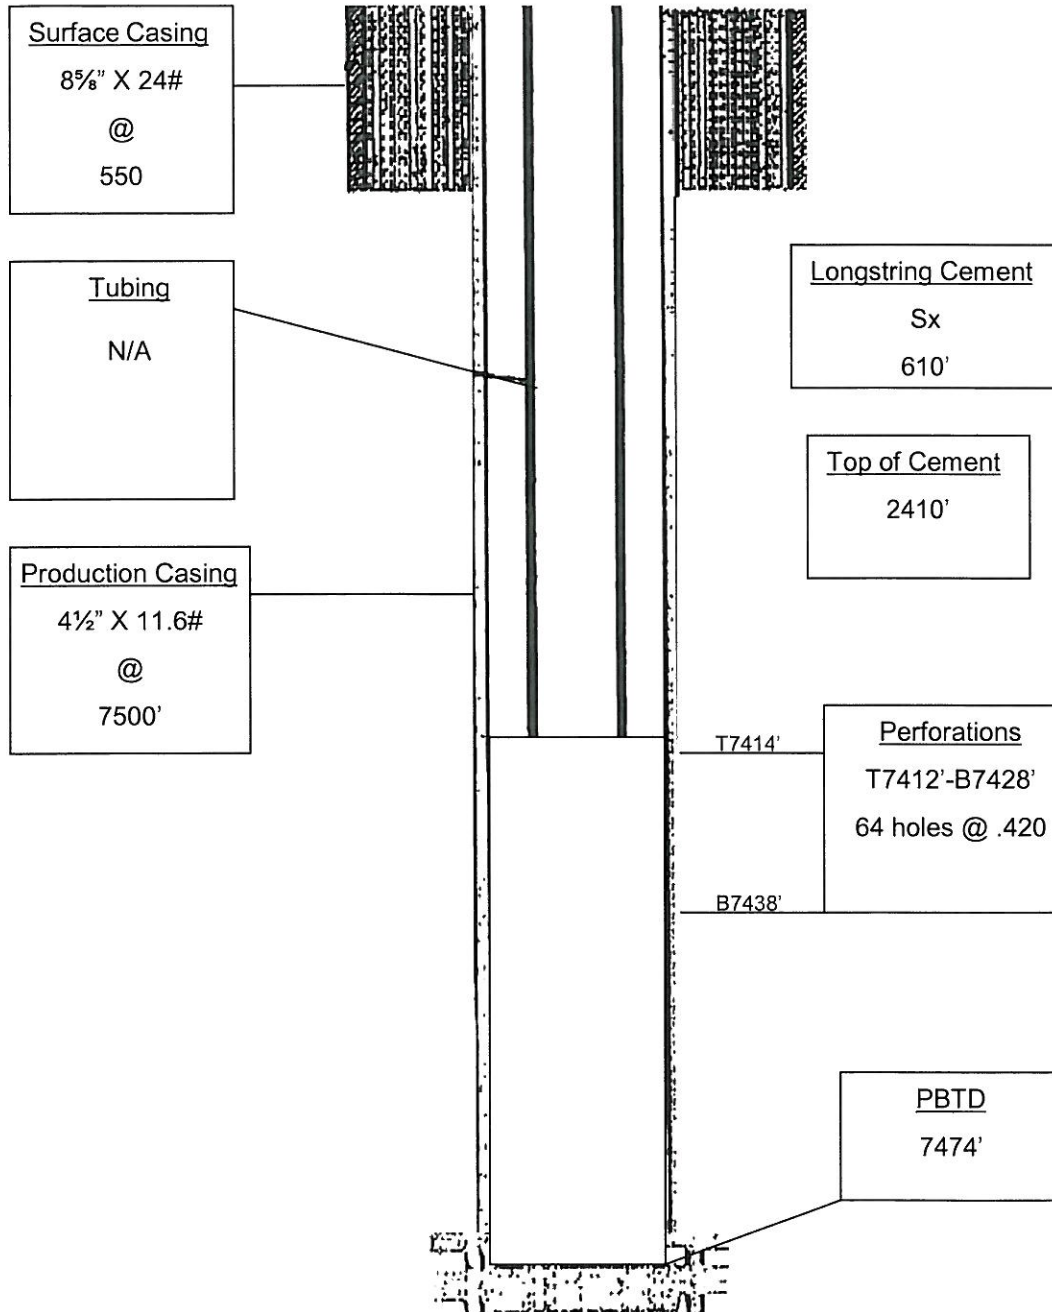

Wellbore Diagram