


NOBLE ENERGY

Pariset #11-11

CURRENT WELLBORE SCHEMATIC

5/12/2011

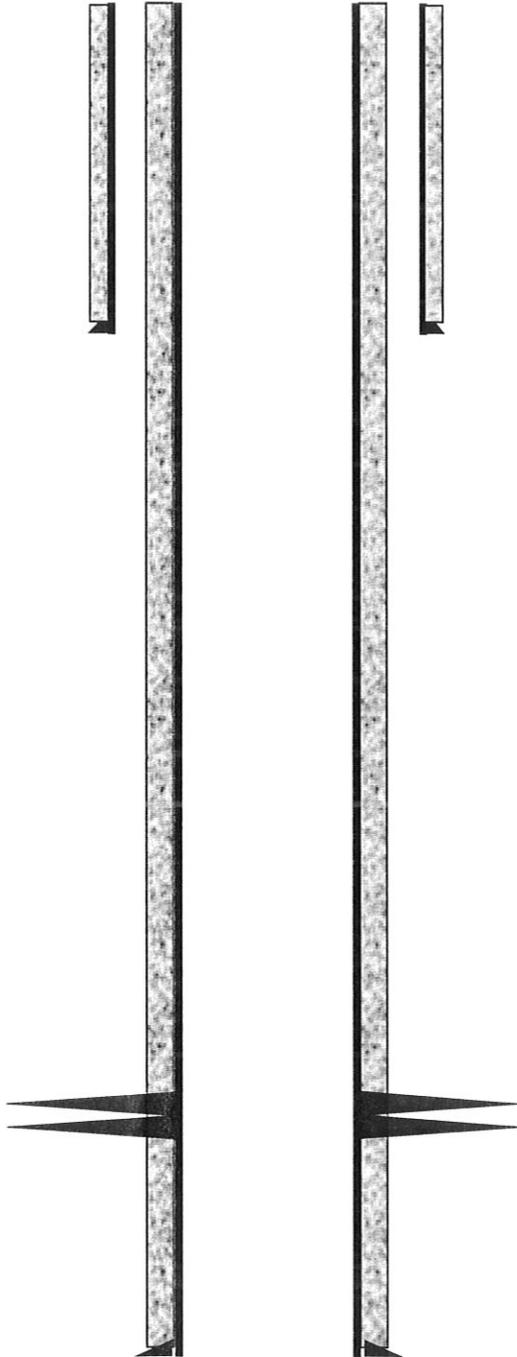

Elevation: 3948' GR, 3954' KB

Location: NWNW Sec 11 - T1S -R46W
Yuma County, CO

Field: Yodel

Spud Date: 7/13/2006

API: 05-125-10046

P&A Date: TBD

Surface Casing:

7" 17#, Set @ 369' in 9-7/8" OH
Cement w/ 141 sx, circ to surface

Perforations:

Niobrara Formation, 2348-2388'

Production Casing:

4-1/2" 11.6#, Set @ 2557' in 6-1/4" OH
Cement w/ 171 sx, circ to surface

PBTD: 2481'
TD: 2561'