


NOBLE ENERGY

Pariset #12-12

CURRENT WELLBORE SCHEMATIC

5/16/2011

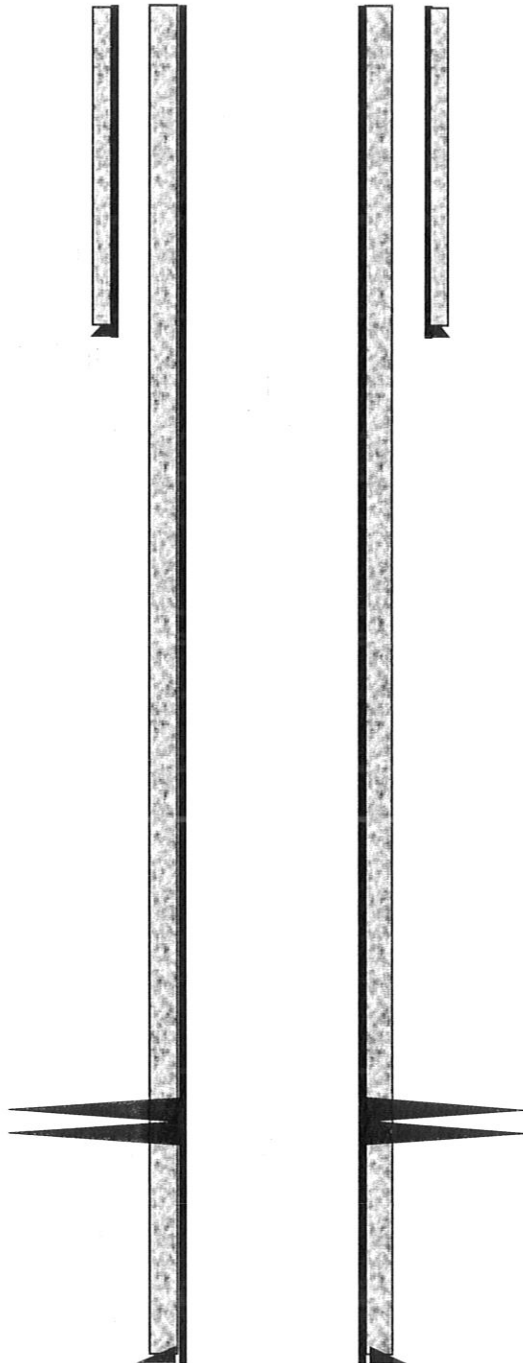

PBTD: 2485'
TD: 2535'

Elevation: 3918' GR, 3924' KB

Location: SWNW Sec 12 - T1S -R46W
Yuma County, CO

Field: Yodel

Spud Date: 7/25/2001

API: 05-125-08316

P&A Date: TBD

Surface Casing:

7" 17#, Set @ 356' in 9-7/8" OH

Cement w/ 150 sx, circ to surface

Perforations:

Niobrara Formation, 2331-2361'

Production Casing:

4-1/2" 10.5#, Set @ 2527' in 6-1/4" OH

Cement w/ 205 sx, circ to surface