



IMPROVEMENTS WITHIN 400' OF THE WELL SITE INCLUDE:  
 AN OVERHEAD POWER LINE PASSES 182' SSE  
 A DIRT FIELD ROAD PASSES 205' SSE  
 THE EDGE OF A CROP CIRCLE IS 107' NE

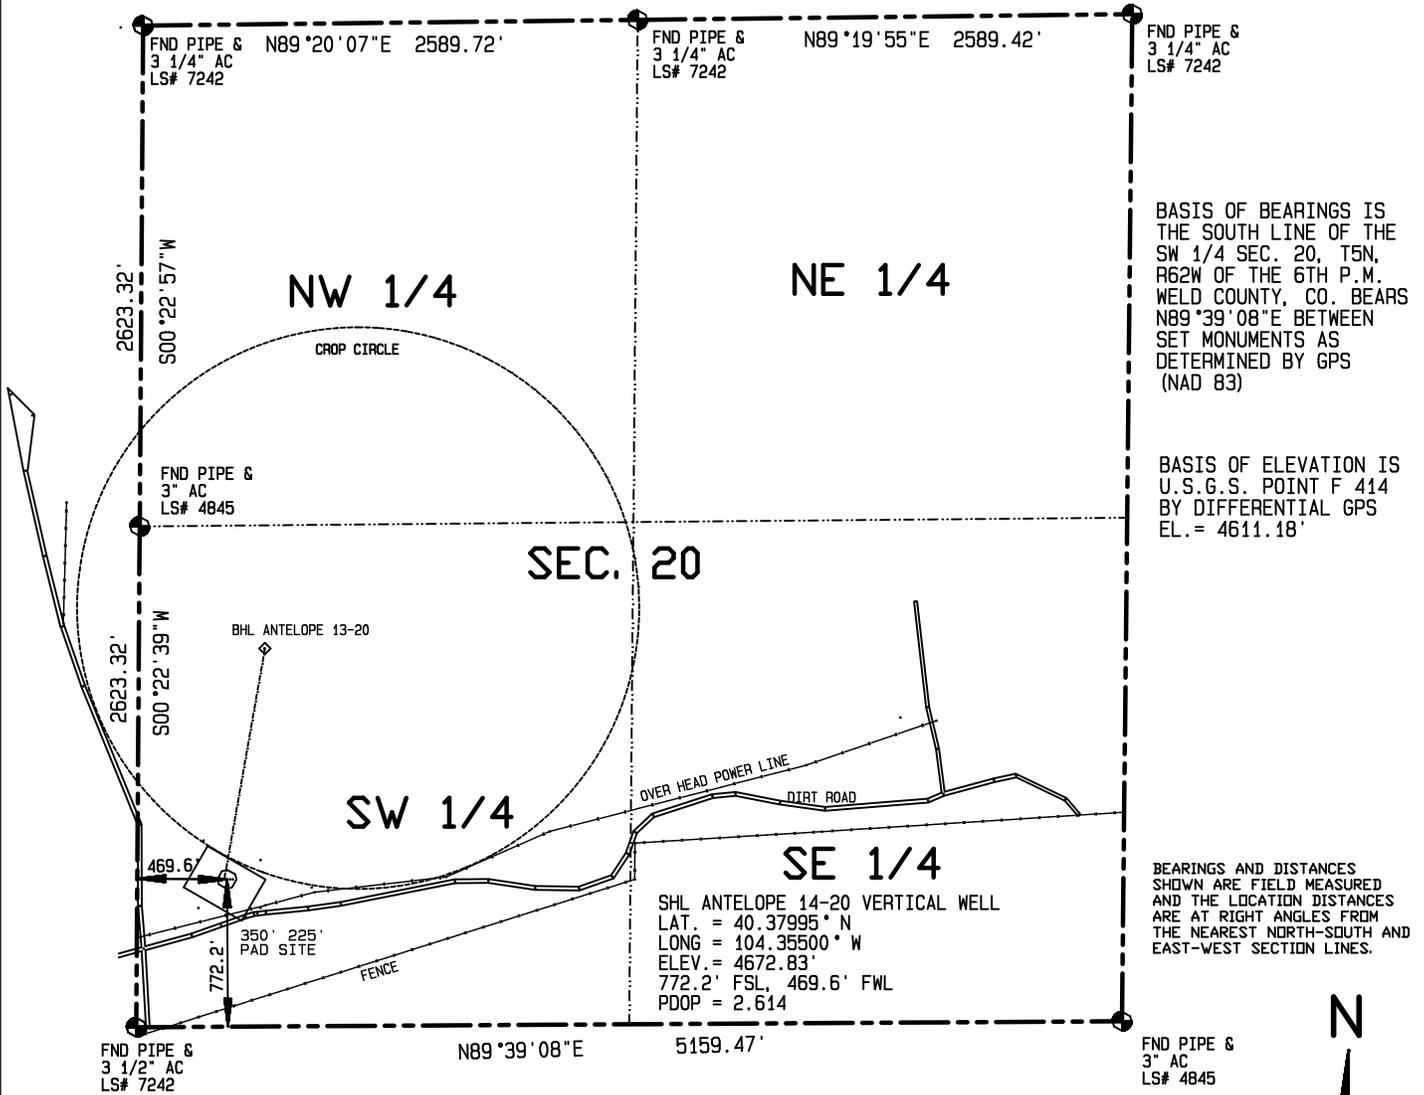

BASIS OF BEARINGS IS THE SOUTH LINE OF THE SW 1/4 SEC. 20, T5N, R62W OF THE 6TH P.M. WELD COUNTY, CO. BEARS N89°39'08"E BETWEEN SET MONUMENTS AS DETERMINED BY GPS (NAD 83)

BASIS OF ELEVATION IS U.S.G.S. POINT F 414 BY DIFFERENTIAL GPS EL. = 4611.18'

BEARINGS AND DISTANCES SHOWN ARE FIELD MEASURED AND THE LOCATION DISTANCES ARE AT RIGHT ANGLES FROM THE NEAREST NORTH-SOUTH AND EAST-WEST SECTION LINES.

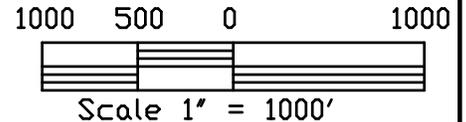


I HEREBY CERTIFY THAT THIS PLAT IS AN ACCURATE REPRESENTATION OF A CORRECT SURVEY SHOWING THE LOCATION OF SAID WELLSITE:

Dan Griggs PLS# 38018

**CONTRACT SURVEYORS, LTD.**  
 COMPLETE SURVEYING AND GLOBAL POSITIONING

2133 SOUTH BELLAIRE STREET #14  
 DENVER COLORADO 80222  
 (303) 756-3695

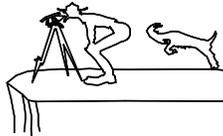

DATE OF FIELD WORK: 10 MAY 2011	DATE OF DRAWING: 11 MAY 2011
ANTELOPE 14-20 PAD SITE Vertical Well	
SW 1/4, SW 1/4 SEC. 20, T5N, R62W	
BONANAZA CREEK ENERGY OPERATING COMPANY, LLC	
WELD COUNTY, COLORADO	