




**Lease Name:** SRC State #16KD

**Legals:** NESW –

Sec. 16, T4N, R67W

**County:** Weld County, Colorado

**API#:** 05-123-31402

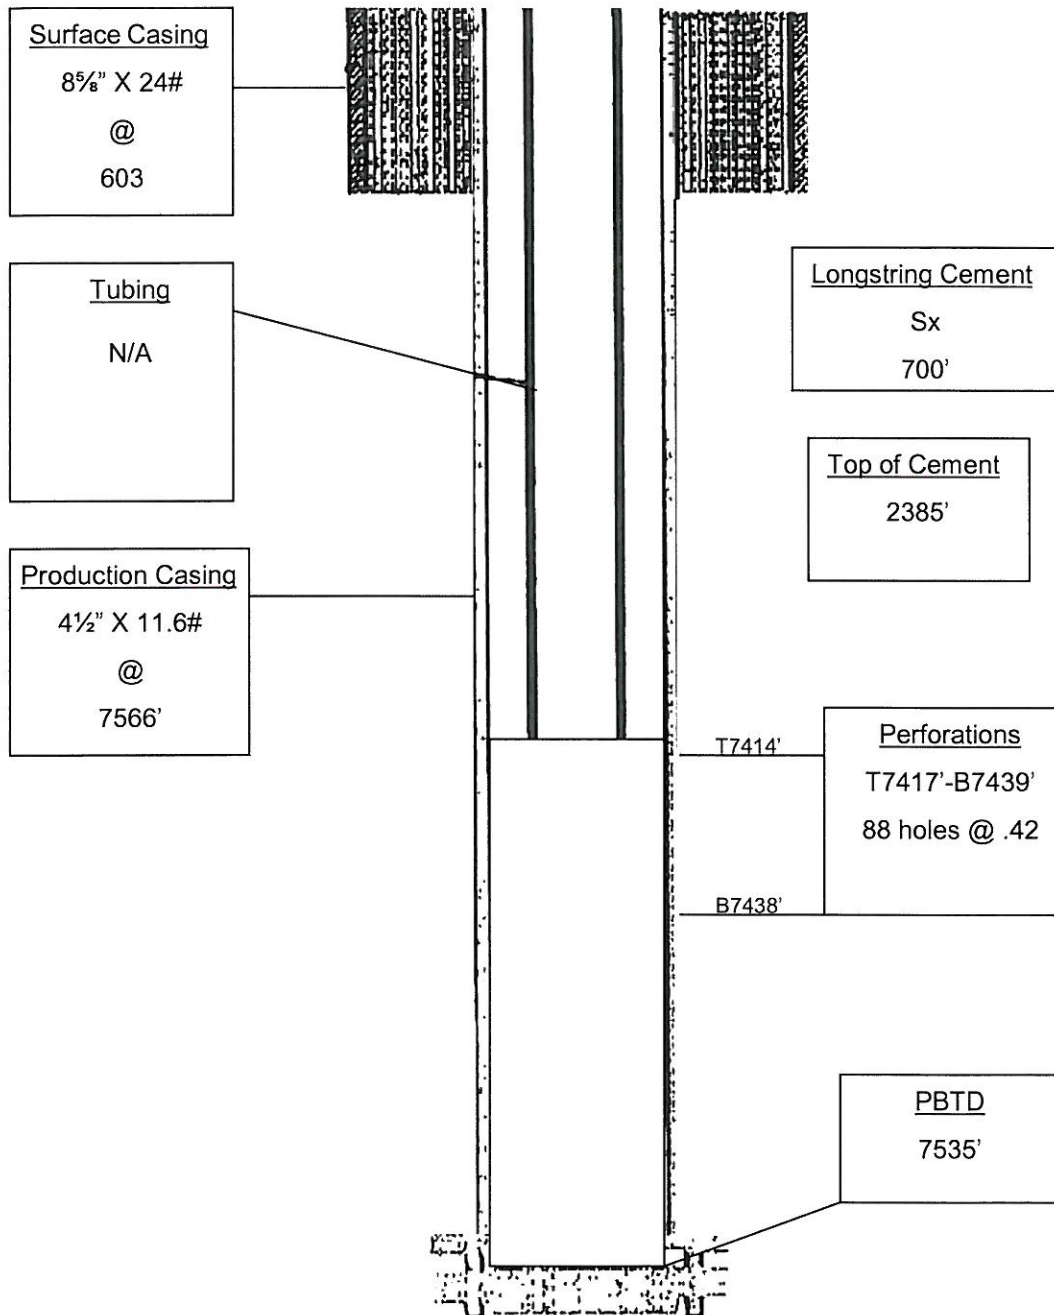

**Wellbore Diagram**